
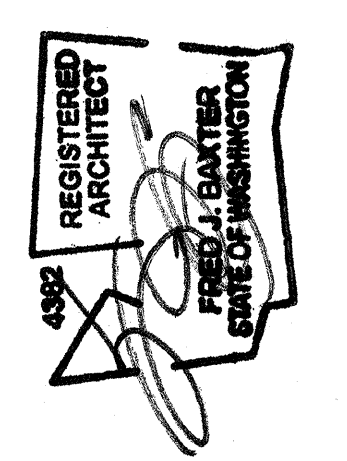
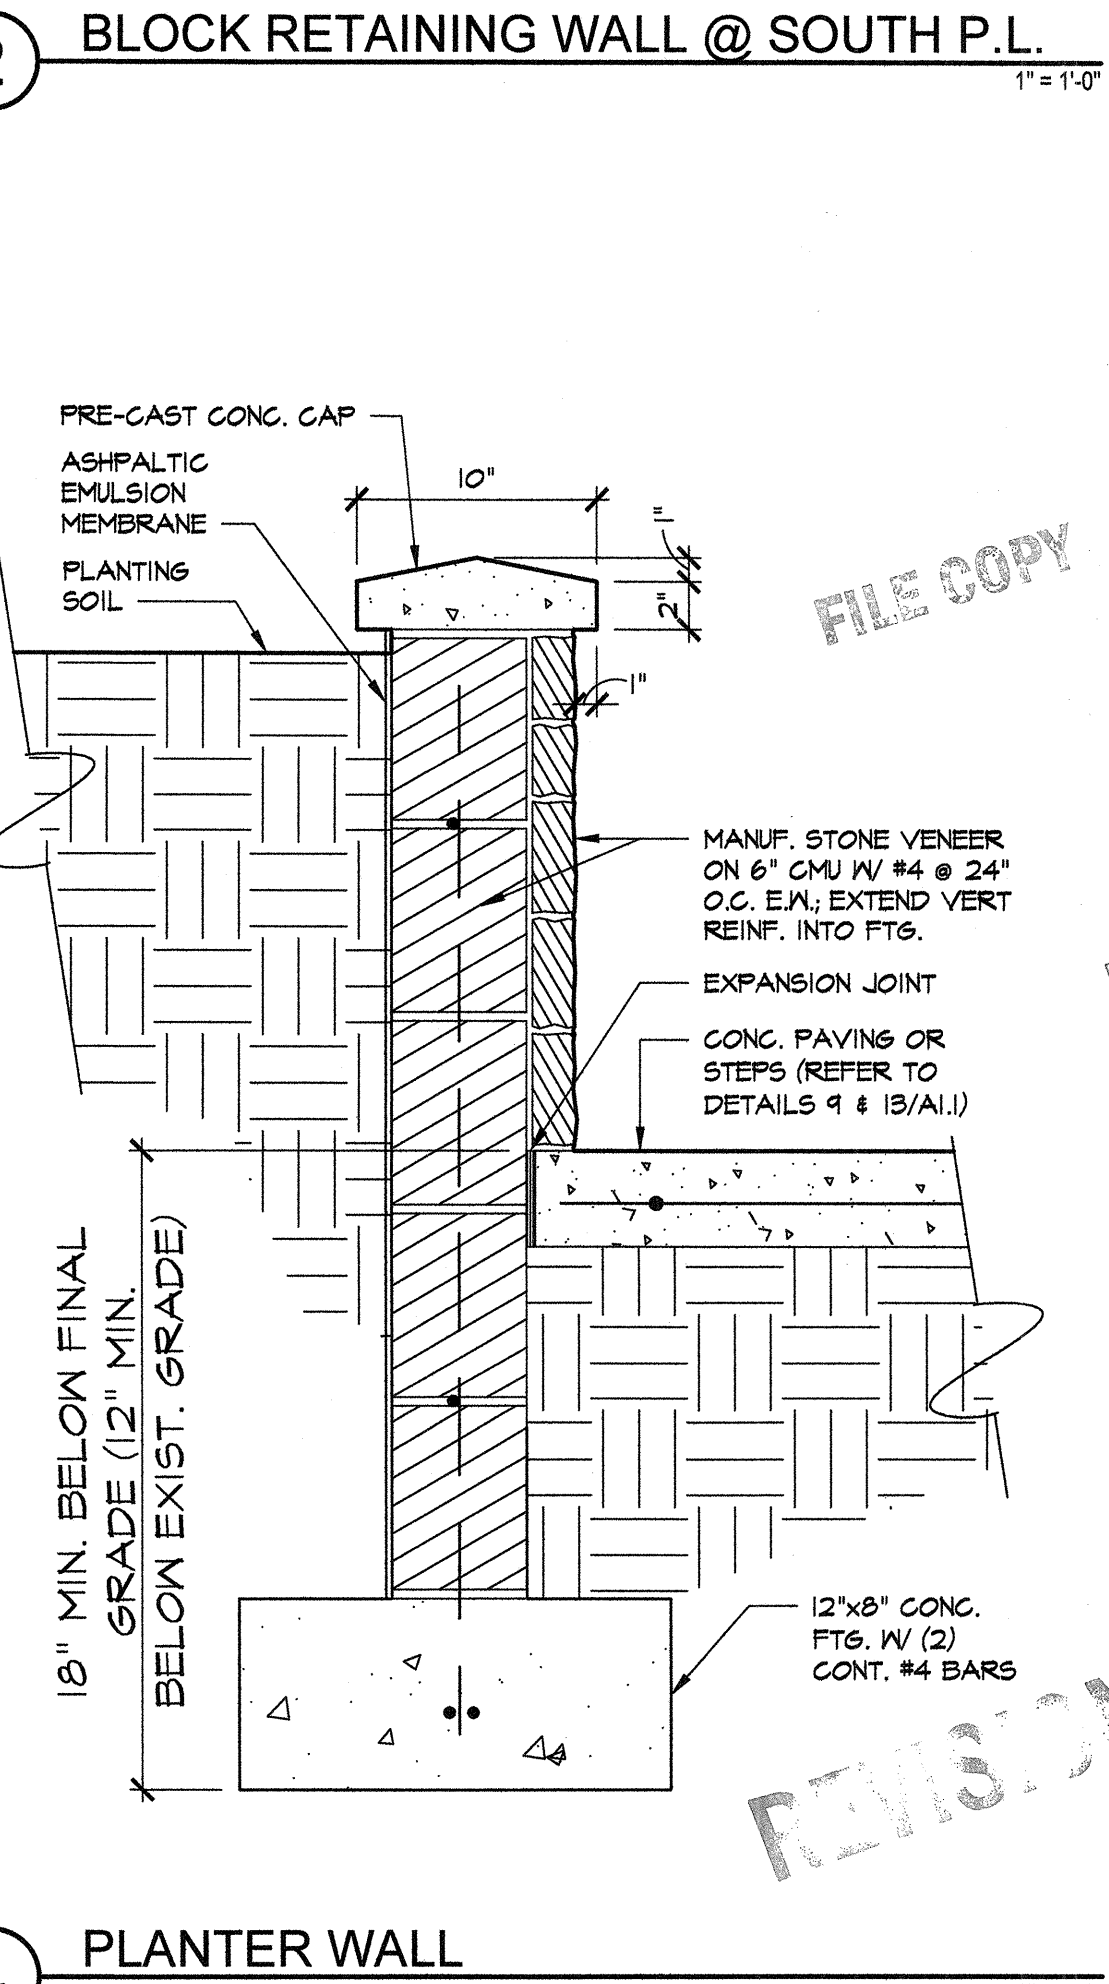
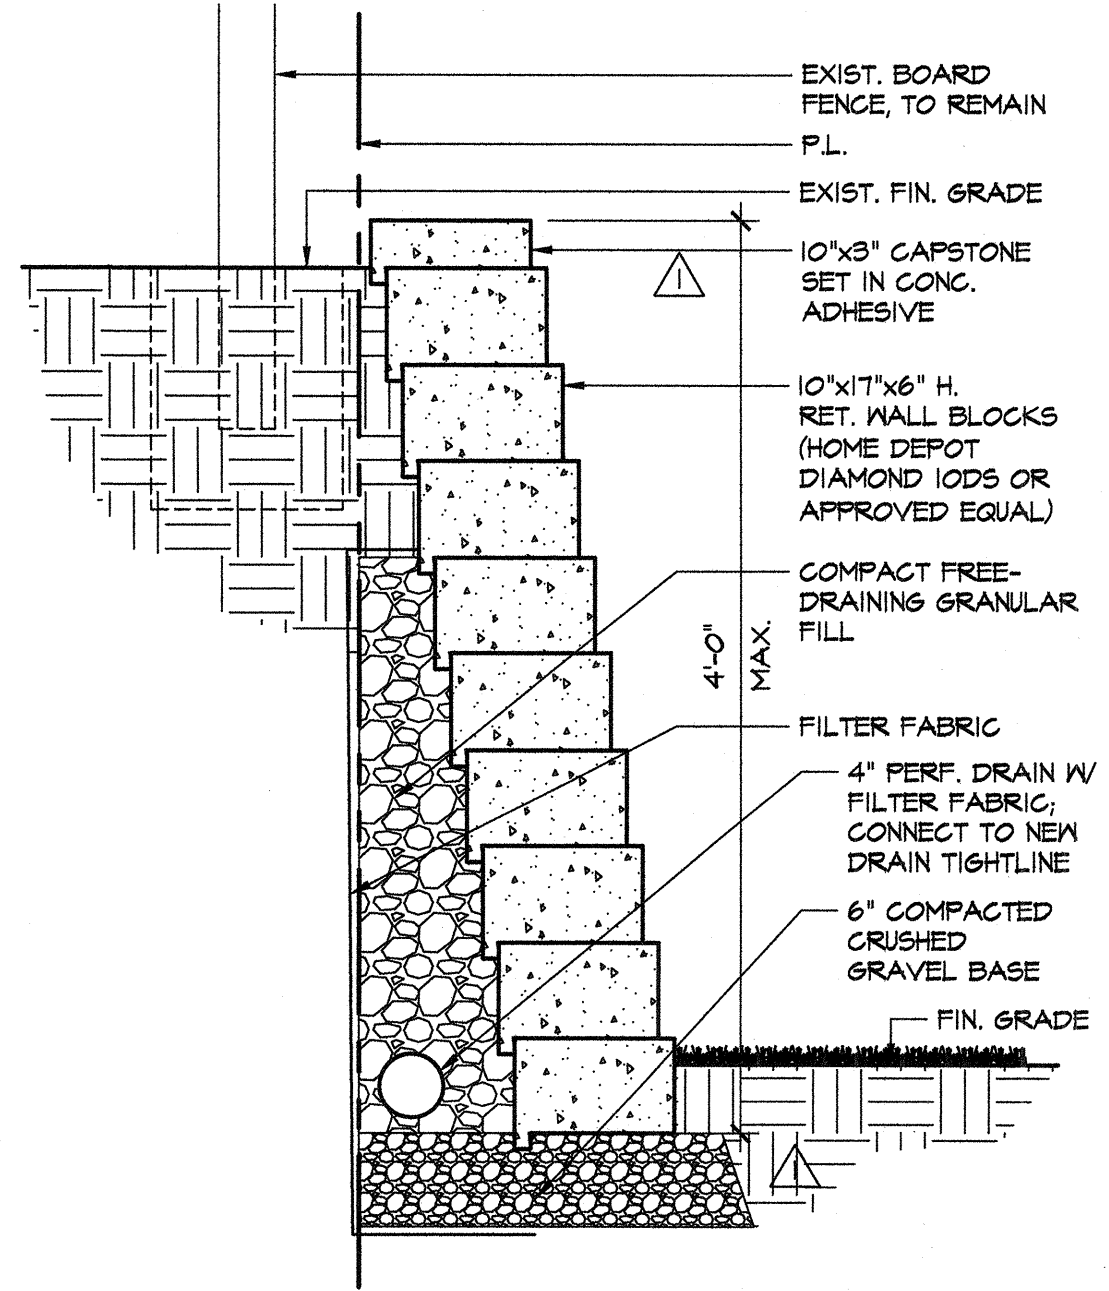
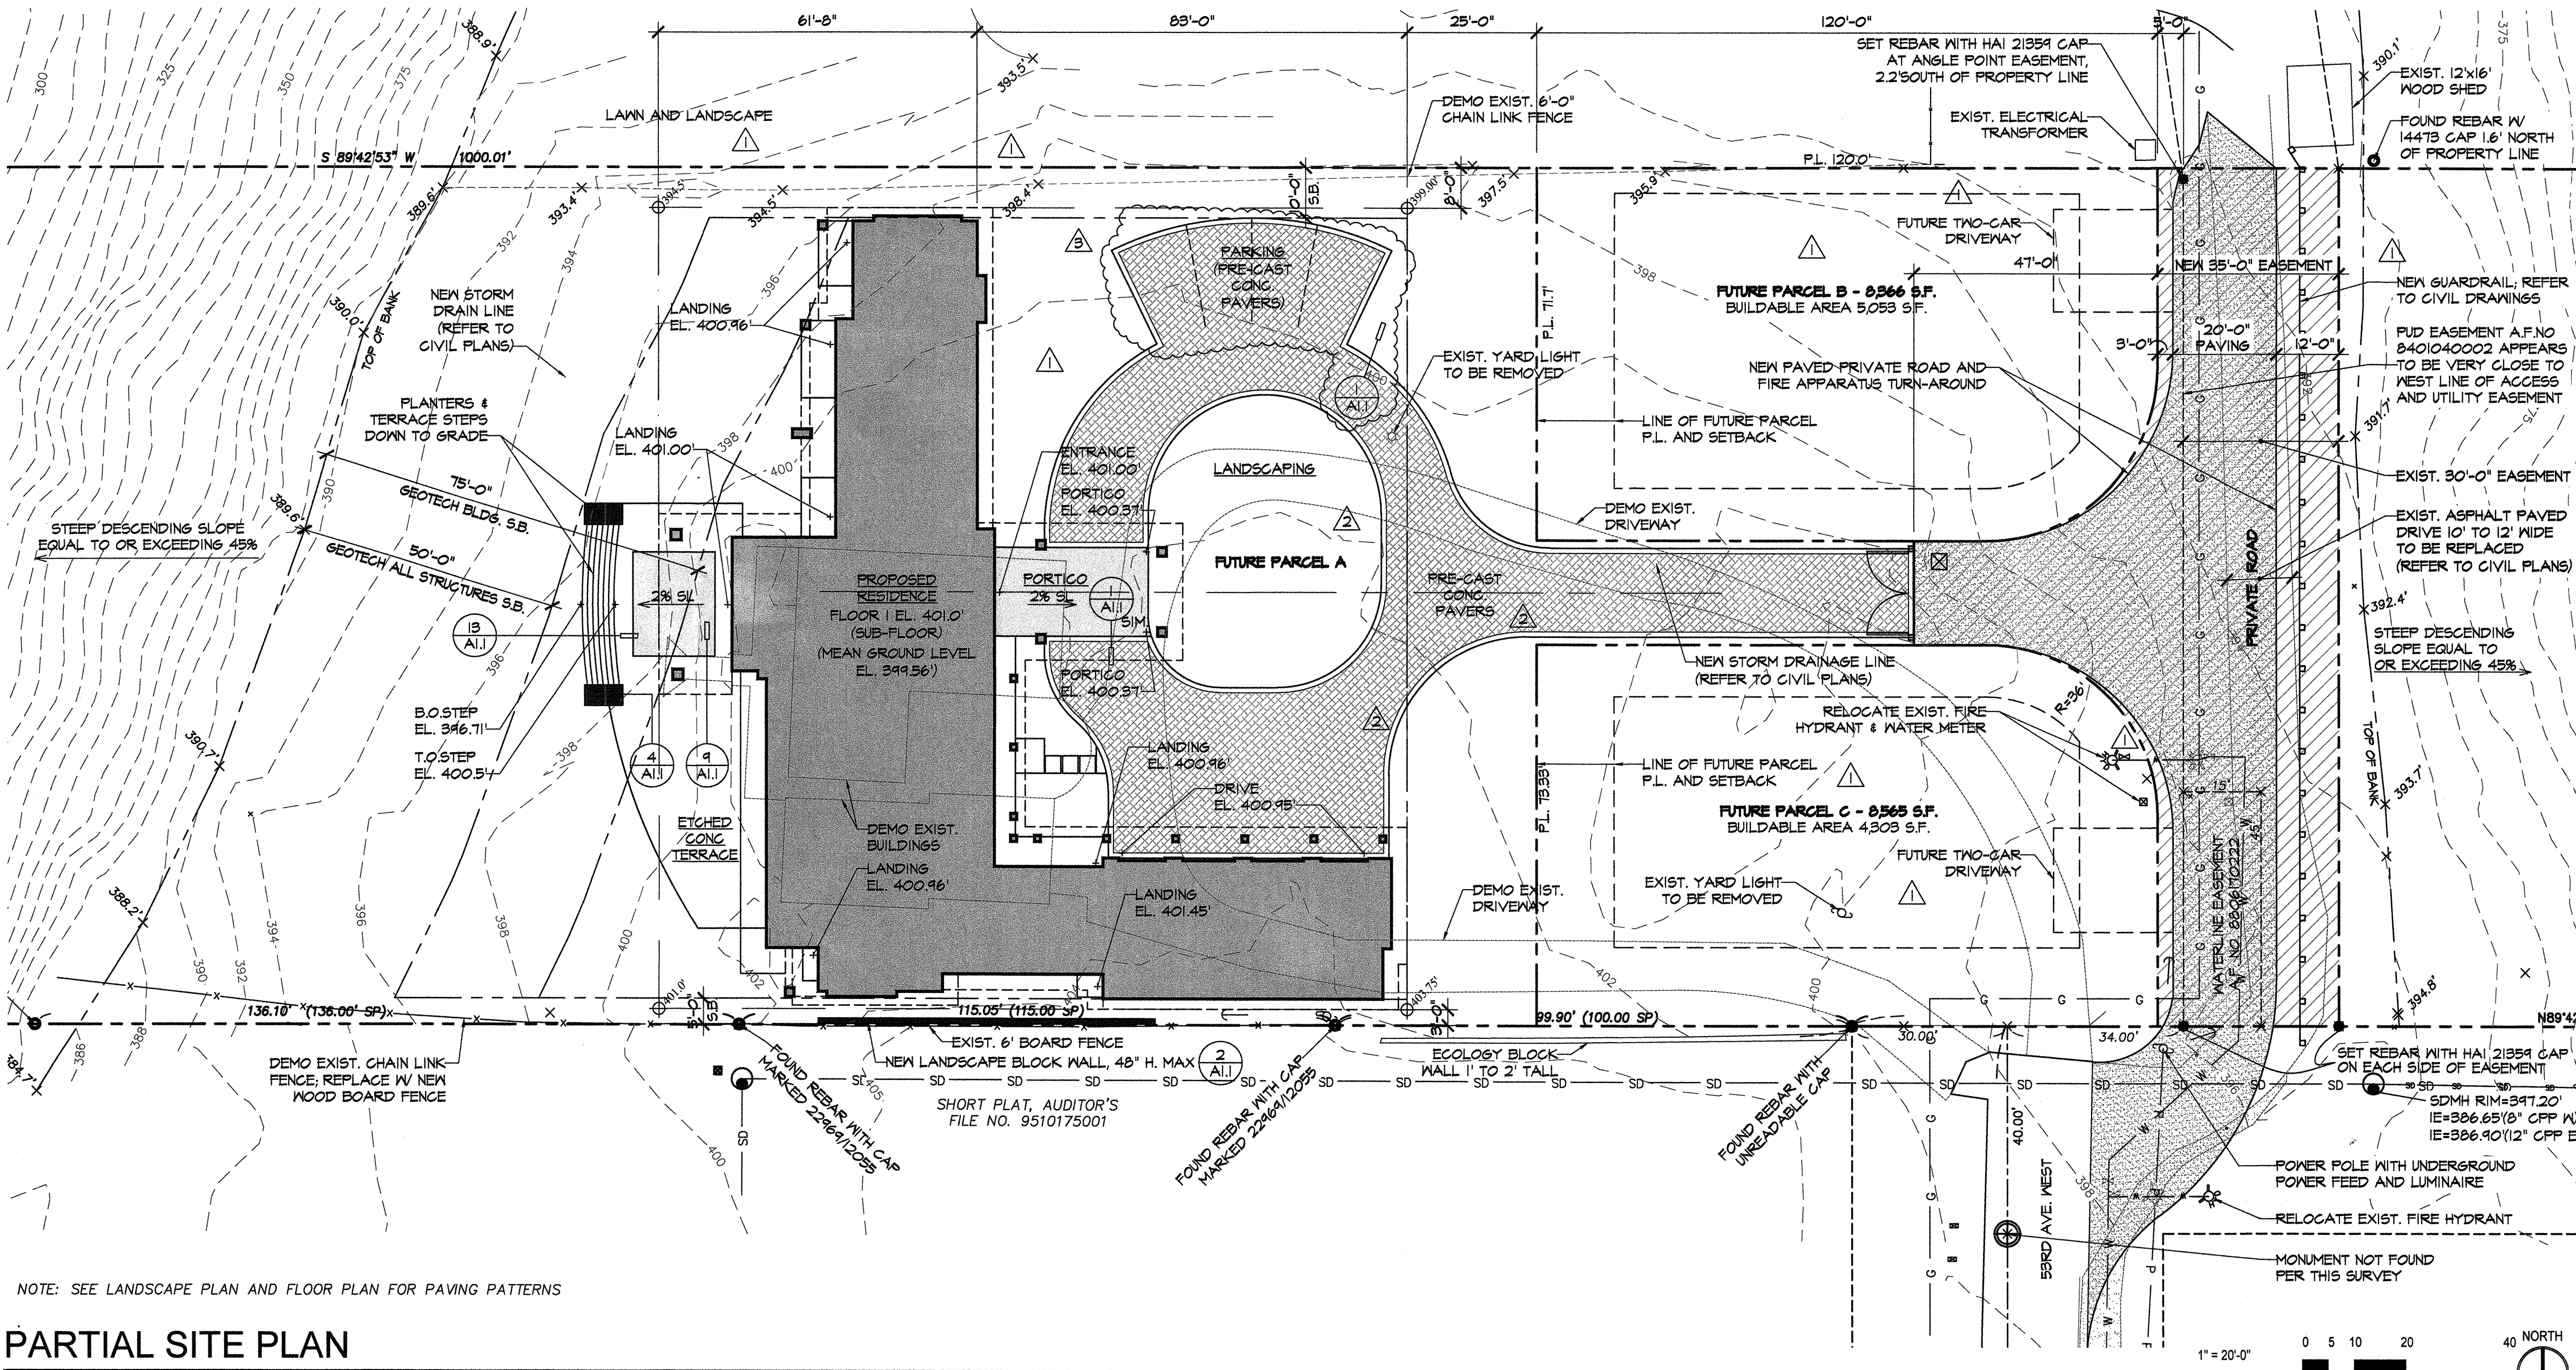
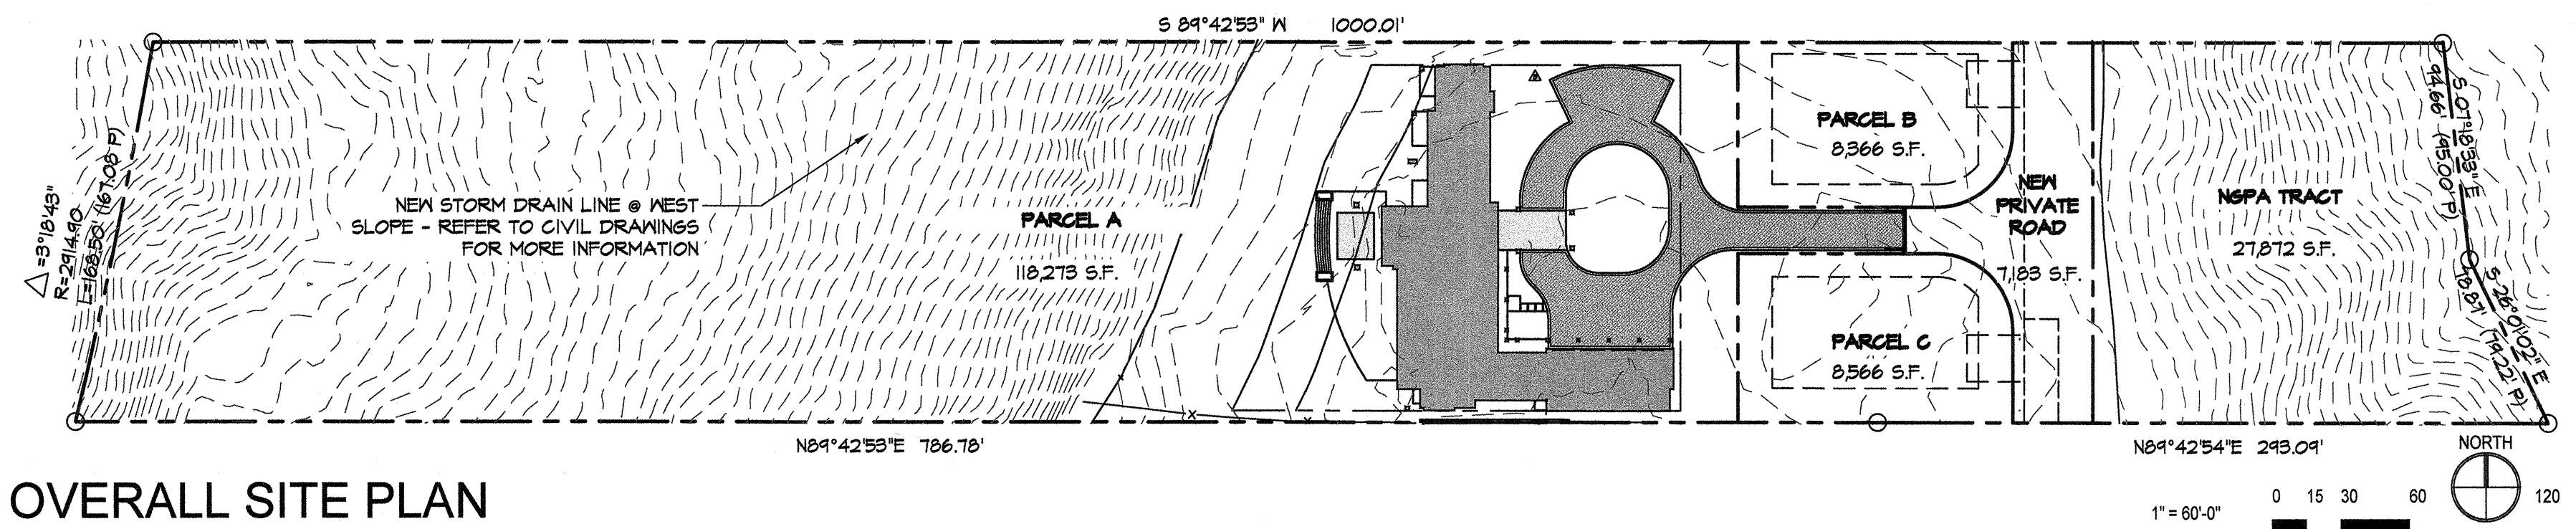
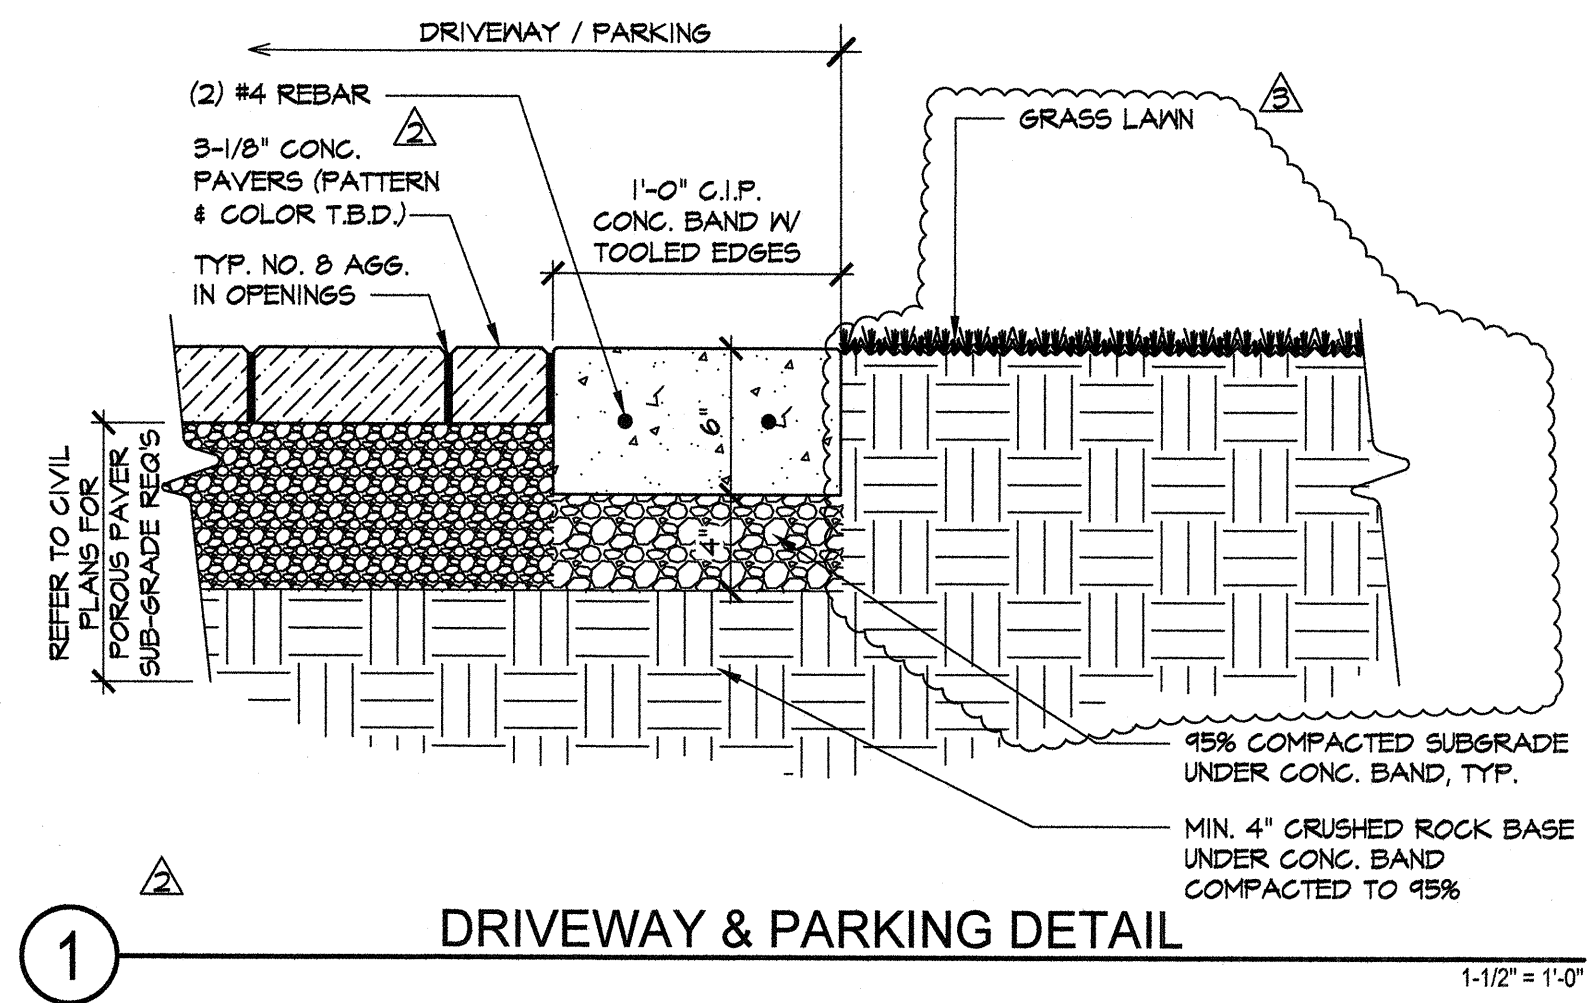
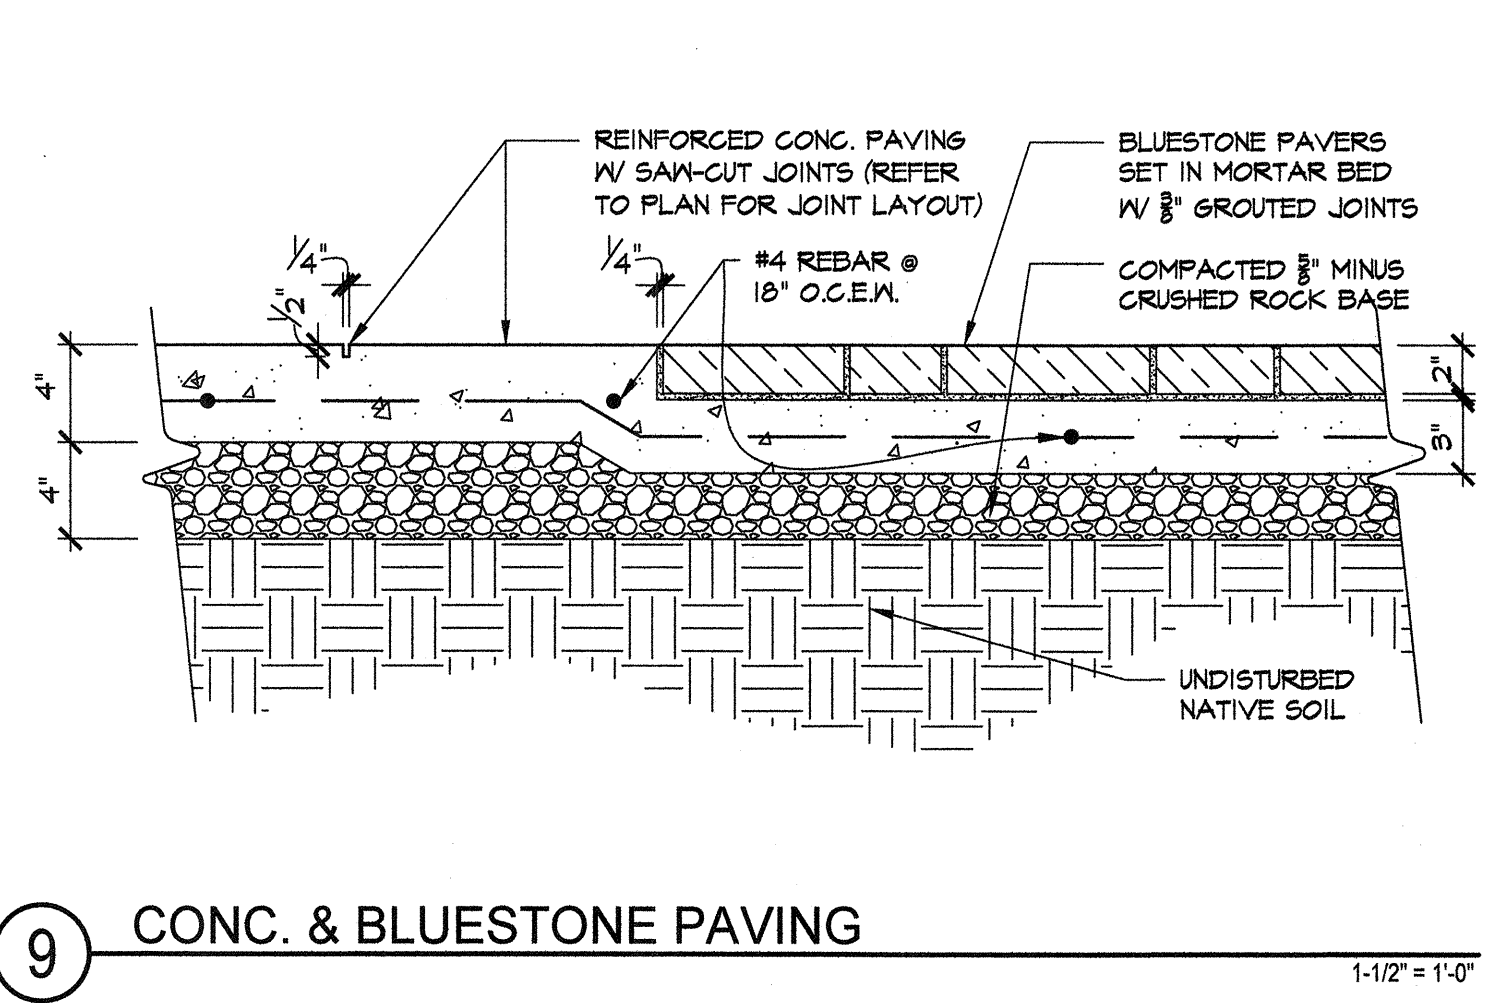


Zhang Family LLC New Residence

ABBREVIATIONS

AB	ANCHOR BOLT	DR	DRAWING	J	JANITOR	PE	PLASTER BASE	TP	TOP OF PAVEMENT
AC	AIR CONDITIONING	EA	EAST	JO	JOIST	PCC	PRECAST CONCRETE	TR	TRANSVERSE
AD	ADDITIONAL	EB	EAST BAY	KE	KITCHEN	PERF	PERFORATED	TS	TIE STEEL
ADU	ADJUSTABLE	EC	EAST CANT	KD	KITCHEN DRAIN	PK	PLYWOOD	TSB	TOP OF SLAB
ADM	ADMINISTRATIVE	EE	EAST ELEVATION	KEG	KITCHEN EQUIPMENT	PL	PROPERTY LINE	TV	TELEVISION
ADR	ADDITIONAL	EF	EAST FINISH	KIT	KITCHEN	PLA	PLASTER	TY	TYPICAL
AF	ABOVE FINISH FLOOR	EG	EAST GROUND	KIT	KITCHEN	PLA	PLASTER	UN	UNFINISHED
AG	AGGREGATE	EH	EAST HILL	KIT	KITCHEN	PLA	PLASTER	UR	UNDERCUT
AH	ALUMINUM	EI	EAST INTERIOR	KIT	KITCHEN	PLA	PLASTER	US	UNDERCUT
AI	ALUMINUM	EJ	EAST JUNCTION	KIT	KITCHEN	PLA	PLASTER	UT	UNDERCUT
AL	ALUMINUM	EK	EAST KITCHEN	KIT	KITCHEN	PLA	PLASTER	UV	UNDERCUT
AM	ALUMINUM	EL	EAST LATH	KIT	KITCHEN	PLA	PLASTER	UX	UNDERCUT
AN	ALUMINUM	EM	EAST MASONRY	KIT	KITCHEN	PLA	PLASTER	UY	UNDERCUT
AO	ALUMINUM	EN	EAST NORTH	KIT	KITCHEN	PLA	PLASTER	UZ	UNDERCUT
AP	ALUMINUM	EO	EAST OUTSIDE	KIT	KITCHEN	PLA	PLASTER	VA	VANISH
APR	APPROXIMATE	EP	EAST PAVEMENT	KIT	KITCHEN	PLA	PLASTER	VB	VAPOR BARRIER
AR	ARCHITECTURAL	EQ	EAST QUARTER	KIT	KITCHEN	PLA	PLASTER	VC	VERTICAL
AS	ASBESTOS	ER	EAST RAMP	KIT	KITCHEN	PLA	PLASTER	VD	VERTICAL
ASB	ASBESTOS	ES	EAST SIDE	KIT	KITCHEN	PLA	PLASTER	VE	VERTICAL
ASST	ASSISTANT	ET	EAST TAIL	KIT	KITCHEN	PLA	PLASTER	VF	VERTICAL
AT	ATMOSPHERE	EU	EAST UPTOWN	KIT	KITCHEN	PLA	PLASTER	VG	VERTICAL
AV	AUDIO VISUAL	EV	EAST VENT	KIT	KITCHEN	PLA	PLASTER	VH	VERTICAL
AW	AUDIO VISUAL	EW	EAST WEST	KIT	KITCHEN	PLA	PLASTER	VI	VERTICAL
AX	AUDIO VISUAL	EX	EAST X	KIT	KITCHEN	PLA	PLASTER	VJ	VERTICAL
AY	AUDIO VISUAL	EY	EAST Y	KIT	KITCHEN	PLA	PLASTER	VK	VERTICAL
AZ	AUDIO VISUAL	EZ	EAST Z	KIT	KITCHEN	PLA	PLASTER	VL	VERTICAL
BA	BOARD	FA	FIRE ALARM	L	LENGTH OF SPAN	PRE	PRECAST	VAR	VANISH
BB	BACK PLATE	FB	FIRE BELL	LAB	LABORATORY	PF	POUR	VB	VAPOR BARRIER
BC	BACK PLATE	FC	FIRE CLOSET	LAV	LABORATORY	PI	PAINT	VC	VERTICAL
BD	BACK PLATE	FD	FIRE DRAIN	LBS	LABORATORY	PTD	PAPER TONE	VD	VERTICAL
BE	BACK PLATE	FE	FIRE EXTINGUISHER	LBS	LABORATORY	PV	POLYVINYL CHLORIDE	VE	VERTICAL
BF	BACK PLATE	FF	FIRE EXTINGUISHER	LBS	LABORATORY	PRE	PRECAST	VF	VERTICAL
BG	BACK PLATE	FG	FIRE EXTINGUISHER	LBS	LABORATORY	PF	POUR	VG	VERTICAL
BH	BACK PLATE	FG	FIRE EXTINGUISHER	LBS	LABORATORY	PI	PAINT	VH	VERTICAL
BI	BACK PLATE	FG	FIRE EXTINGUISHER	LBS	LABORATORY	PTD	PAPER TONE	VI	VERTICAL
BJ	BACK PLATE	FG	FIRE EXTINGUISHER	LBS	LABORATORY	PV	POLYVINYL CHLORIDE	VJ	VERTICAL
BK	BACK PLATE	FG	FIRE EXTINGUISHER	LBS	LABORATORY	PRE	PRECAST	VK	VERTICAL
BL	BACK PLATE	FG	FIRE EXTINGUISHER	LBS	LABORATORY	PF	POUR	VL	VERTICAL
BM	BACK PLATE	FG	FIRE EXTINGUISHER	LBS	LABORATORY	PI	PAINT	VM	VERTICAL
BN	BACK PLATE	FG	FIRE EXTINGUISHER	LBS	LABORATORY	PTD	PAPER TONE	VN	VERTICAL
BO	BACK PLATE	FG	FIRE EXTINGUISHER	LBS	LABORATORY	PV	POLYVINYL CHLORIDE	VO	VERTICAL
BP	BACK PLATE	FG	FIRE EXTINGUISHER	LBS	LABORATORY	PRE	PRECAST	VP	VERTICAL
BQ	BACK PLATE	FG	FIRE EXTINGUISHER	LBS	LABORATORY	PF	POUR	VQ	VERTICAL
BR	BACK PLATE	FG	FIRE EXTINGUISHER	LBS	LABORATORY	PI	PAINT	VR	VERTICAL
BS	BACK PLATE	FG	FIRE EXTINGUISHER	LBS	LABORATORY	PTD	PAPER TONE	VS	VERTICAL
BT	BACK PLATE	FG	FIRE EXTINGUISHER	LBS	LABORATORY	PV	POLYVINYL CHLORIDE	VT	VERTICAL
BV	BACK PLATE	FG	FIRE EXTINGUISHER	LBS	LABORATORY	PRE	PRECAST	VT	VERTICAL
BW	BACK PLATE	FG	FIRE EXTINGUISHER	LBS	LABORATORY	PF	POUR	VU	VERTICAL
BX	BACK PLATE	FG	FIRE EXTINGUISHER	LBS	LABORATORY	PI	PAINT	VV	VERTICAL
BY	BACK PLATE	FG	FIRE EXTINGUISHER	LBS	LABORATORY	PTD	PAPER TONE	VV	VERTICAL
BZ	BACK PLATE	FG	FIRE EXTINGUISHER	LBS	LABORATORY	PV	POLYVINYL CHLORIDE	VW	VERTICAL
CA	CABINET	GA	GENERAL	LAB	LABORATORY	PRE	PRECAST	VB	VAPOR BARRIER
CB	CABINET	GB	GENERAL	LAV	LABORATORY	PI	PAINT	VC	VERTICAL
CC	CABINET	GC	GENERAL	LBS	LABORATORY	PTD	PAPER TONE	VD	VERTICAL
CD	CABINET	GD	GENERAL	LBS	LABORATORY	PV	POLYVINYL CHLORIDE	VE	VERTICAL
CE	CABINET	GE	GENERAL	LBS	LABORATORY	PRE	PRECAST	VF	VERTICAL
CF	CABINET	GF	GENERAL	LBS	LABORATORY	PF	POUR	VG	VERTICAL
CG	CABINET	GG	GENERAL	LBS	LABORATORY	PI	PAINT	VH	VERTICAL
CH	CABINET	GH	GENERAL	LBS	LABORATORY	PTD	PAPER TONE	VI	VERTICAL
CI	CABINET	GI	GENERAL	LBS	LABORATORY	PV	POLYVINYL CHLORIDE	VJ	VERTICAL
CJ	CABINET	GO	GENERAL	LBS	LABORATORY	PRE	PRECAST	VK	VERTICAL
CK	CABINET	GP	GENERAL	LBS	LABORATORY	PF	POUR	VL	VERTICAL
CL	CABINET	GQ	GENERAL	LBS	LABORATORY	PI	PAINT	VM	VERTICAL
CM	CABINET	GR	GENERAL	LBS	LABORATORY	PTD	PAPER TONE	VN	VERTICAL
CN	CABINET	GS	GENERAL	LBS	LABORATORY	PV	POLYVINYL CHLORIDE	VO	VERTICAL
CO	CABINET	GT	GENERAL	LBS	LABORATORY	PRE	PRECAST	VP	VERTICAL
CP	CABINET	GU	GENERAL	LBS	LABORATORY	PF	POUR	VQ	VERTICAL
CQ	CABINET	GV	GENERAL	LBS	LABORATORY	PI	PAINT	VR	VERTICAL
CR	CABINET	GW	GENERAL	LBS	LABORATORY	PTD	PAPER TONE	VS	VERTICAL
CS	CABINET	GX	GENERAL	LBS	LABORATORY	PV	POLYVINYL CHLORIDE	VT	VERTICAL
CT	CABINET	GY	GENERAL	LBS	LABORATORY	PRE	PRECAST	VT	VERTICAL
CU	CABINET	GZ	GENERAL	LBS	LABORATORY	PF	POUR	VU	VERTICAL
CV	CABINET	HA	HARDWARE	LBS	LABORATORY	PI	PAINT	VV	VERTICAL
CW	CABINET	HB	HARDWARE	LBS	LABORATORY	PTD	PAPER TONE	VV	VERTICAL
CX	CABINET	HC	HARDWARE	LBS	LABORATORY	PV	POLYVINYL CHLORIDE	VW	VERTICAL
CY	CABINET	HD	HARDWARE	LBS	LABORATORY	PRE	PRECAST	VW	VERTICAL
CZ	CABINET	HE	HARDWARE	LBS	LABORATORY	PF	POUR	VX	VERTICAL
DA	DOUBLE	HF	HARDWARE	LBS	LABORATORY	PI	PAINT	VY	VERTICAL
DB	DOUBLE	HG	HARDWARE	LBS	LABORATORY	PTD	PAPER TONE	VZ	VERTICAL
DC	DOUBLE	HH	HARDWARE	LBS	LABORATORY	PV	POLYVINYL CHLORIDE	WA	WOOD
DD	DOUBLE	HI	HARDWARE	LBS	LABORATORY	PRE	PRECAST	WB	WOOD
DE	DOUBLE	HJ	HARDWARE	LBS	LABORATORY	PF	POUR	WC	WOOD
DF	DOUBLE	HK	HARDWARE	LBS	LABORATORY	PI	PAINT	WD	WOOD
DG	DOUBLE	HL	HARDWARE	LBS	LABORATORY	PTD	PAPER TONE	WE	WOOD
DH	DOUBLE	HM	HARDWARE	LBS	LABORATORY	PV	POLYVINYL CHLORIDE	WF	WOOD
DI	DOUBLE	HN	HARDWARE	LBS	LABORATORY	PRE	PRECAST	WG	WOOD
DJ	DOUBLE	HO	HARDWARE	LBS	LABORATORY	PF	POUR	WH	WOOD
DK	DOUBLE	HP	HARDWARE	LBS	LABORATORY	PI	PAINT	WI	WOOD
DL	DOUBLE	HQ	HARDWARE	LBS	LABORATORY	PTD	PAPER TONE	WJ	WOOD
DM	DOUBLE	HR	HARDWARE	LBS	LABORATORY	PV	POLYVINYL CHLORIDE	WK	WOOD
DN	DOUBLE	HS	HARDWARE	LBS	LABORATORY	PRE	PRECAST	WL	WOOD
DO	DOUBLE	HT	HARDWARE	LBS	LABORATORY	PF	POUR	WM	WOOD
DP	DOUBLE	HU	HARDWARE	LBS	LABORATORY	PI	PAINT	WN	WOOD
DQ	DOUBLE	HV	HARDWARE	LBS	LABORATORY	PTD	PAPER TONE	WO	WOOD
DR	DOUBLE	HW	HARDWARE	LBS	LABORATORY	PV	POLYVINYL CHLORIDE	WP	WOOD
DS	DOUBLE	HX	HARDWARE	LBS	LABORATORY	PRE	PRECAST	WQ	WOOD
DT	DOUBLE	HY	HARDWARE	LBS	LABORATORY	PF	POUR	WR	WOOD
DU	DOUBLE	HZ	HARDWARE	LBS	LABORATORY	PI	PAINT	WS	WOOD
DV	DOUBLE	IA	INTERIOR	LBS	LABORATORY	PTD	PAPER TONE	WT	WOOD
DW	DOUBLE	IB	INTERIOR	LBS	LABORATORY	PV	POLYVINYL CHLORIDE	WU	WOOD
DX	DOUBLE	IC	INTERIOR	LBS	LABORATORY	PRE	PRECAST	WV	WOOD
DY	DOUBLE	ID	INTERIOR	LBS	LABORATORY	PF	POUR	WW	WOOD
DZ	DOUBLE	IE	INTERIOR	LBS	LABORATORY	PI	PAINT	WX	WOOD
EA	EAST	IF	INTERIOR	LBS	LABORATORY	PTD	PAPER TONE	WY	WOOD
EB	EAST	IG	INTERIOR	LBS	LABORATORY	PV	POLYVINYL CHLORIDE	WZ	WOOD
EC	EAST	IH	INTERIOR	LBS	LABORATORY	PRE	PRECAST	XA	WOOD
ED	EAST	II	INTERIOR	LBS	LABORATORY	PF	POUR	XB	WOOD
EE	EAST	IJ	INTERIOR	LBS	LABORATORY	PI	PAINT	XC	WOOD
EF	EAST	IK	INTERIOR	LBS	LABORATORY	PTD	PAPER TONE	XD	WOOD
EG	EAST	IL	INTERIOR	LBS	LABORATORY	PV	POLYVINYL CHLORIDE	XE	WOOD
EH	EAST	IM	INTERIOR	LBS	LABORATORY	PRE	PRECAST	XF	WOOD
EI	EAST	IN	INTERIOR	LBS	LABORATORY	PF	POUR	XG	WOOD
EJ	EAST	IO	INTERIOR	LBS	LABORATORY	PI	PAINT	XH	WOOD
EK	EAST	IP	INTERIOR	LBS	LABORATORY	PTD	PAPER TONE	XI	WOOD
EL	EAST	IQ	INTERIOR	LBS	LABORATORY	PV	POLYVINYL CHLORIDE	XJ	WOOD
EM	EAST	IR	INTERIOR	LBS	LABORATORY	PRE	PRECAST	XK	WOOD
EN	EAST	IS	INTERIOR	LBS	LABORATORY	PF	POUR	XL	WOOD
EO	EAST	IT	INTERIOR	LBS	LABORATORY	PI	PAINT	XM	WOOD
EP	EAST	IU	INTERIOR	LBS	LABORATORY	PTD	PAPER TONE	XN	WOOD
EQ	EAST	IV	INTERIOR	LBS	LABORATORY	PV	POLYVINYL CHLORIDE	XO	WOOD
ER	EAST	IW	INTERIOR	LBS	LABORATORY	PRE	PRECAST	XP	WOOD
ES	EAST	IX	INTERIOR	LBS	LABORATORY	PF	POUR	XQ	WOOD
ET	EAST	IY	INTERIOR	LBS	LABORATORY	PI	PAINT	XR	WOOD
EU	EAST	IZ	INTERIOR	LBS	LABORATORY	PTD	PAPER TONE	XS	WOOD
EV	EAST	JA	JANITOR	LBS	LABORATORY	PV	POLYVINYL CHLORIDE	XT	WOOD
EW	EAST	JB	JANITOR	LBS	LABORATORY	PRE	PRECAST	XU	WOOD
EX	EAST	JC	JANITOR	LBS	LABORATORY	PF	POUR	XV	WOOD
EY	EAST	JD	JANITOR	LBS	LABORATORY	PI	PAINT	XW	WOOD
EZ	EAST	JE	JANITOR	LBS	LABORATORY	PTD	PAPER TONE	XX	WOOD
FA	FIRE ALARM	JF	JANITOR	LBS	LABORATORY	PV	POLYVINYL CHLORIDE	XY	WOOD
FB	FIRE ALARM	JG	JANITOR	LBS	LABORATORY	PRE	PRECAST	YZ	WOOD
FC	FIRE ALARM	JH	JANITOR	LBS	LABORATORY	PF	POUR	ZA	WOOD
FD	FIRE ALARM	JI	JANITOR	LBS	LABORATORY	PI	PAINT	ZB	WOOD
FE	FIRE ALARM	JJ	JANITOR	LBS	LABORATORY	PTD	PAPER TONE	ZC	WOOD
FF	FIRE ALARM	JK	JANITOR	LBS	LABORATORY	PV	POLYVINYL CHLORIDE	ZD	WOOD
FG	FIRE ALARM	JL	JANITOR	LBS	LABORATORY	PRE	PRECAST	ZE	WOOD
FH	FIRE ALARM	JM	JANITOR	LBS	LABORATORY	PF	POUR	ZF	WOOD
FI	FIRE ALARM	JN	JANITOR	LBS	LABORATORY	PI	PAINT	ZG	WOOD
FJ	FIRE ALARM	JO	JANITOR	LBS	LABORATORY	PTD	PAPER TONE	ZH	WOOD
FK	FIRE ALARM	JP	JANITOR	LBS	LABORATORY	PV	POLYVINYL CHLORIDE	ZI	WOOD
FL	FIRE ALARM	JQ	JANITOR	LBS	LABORATORY	PRE	PRECAST	ZJ	WOOD
FM	FIRE ALARM	JR	JANITOR	LBS	LABORATORY	PF	POUR	ZK	WOOD
FN	FIRE ALARM	JS	JANITOR	LBS	LABORATORY	PI	PAINT	ZL	WOOD
FO	FIRE ALARM	JT	JANITOR	LBS	LABORATORY	PTD	PAPER TONE	ZM	WOOD
FP	FIRE ALARM	JU	JANITOR	LBS	LABORATORY	PV	POLYVINYL CHLORIDE	ZN	WOOD
FQ	FIRE ALARM	JV	JANITOR	LBS	LABORATORY	PRE	PRECAST	ZO	WOOD
FR	FIRE ALARM	JW	JANITOR	LBS	LABORATORY	PF	POUR	ZP	WOOD
FS	FIRE ALARM	JX	JANITOR	LBS	LABORATORY	PI	PAINT	ZQ	WOOD
FT	FIRE ALARM	JY	JANITOR	LBS	LABORATORY	PTD	PAPER TONE	ZR	WOOD
FU	FIRE ALARM	JZ	JANITOR	LBS	LABORATORY	PV	POLYVINYL CHLORIDE	ZS	WOOD
FV	FIRE ALARM	KA	KITCHEN	LBS	LABORATORY	PRE	PRECAST	ZT	WOOD
FW	FIRE ALARM	KB	KITCHEN	LBS	LABORATORY	PF	POUR	ZU	WOOD
FX	FIRE ALARM	KC	KITCHEN	LBS	LABORATORY	PI	PAINT	ZV	WOOD
FY	FIRE ALARM	KD	KITCHEN	LBS	LABORATORY	PTD	PAPER TONE	ZW	WOOD
FZ	FIRE ALARM	KE	KITCHEN	LBS	LABORATORY	PV	POLYVINYL CHLORIDE	ZX	WOOD
GA	GENERAL	KF	KITCHEN	LBS	LABORATORY	PRE	PRECAST	ZY	WOOD
GB	GENERAL	KG	KITCHEN	LBS	LABORATORY	PF	POUR	ZZ	WOOD
GC	GENERAL	KH	KITCHEN	LBS	LABORATORY	PI	PAINT		
GD	GENERAL	KI	KITCHEN	LBS	LABORATORY	PTD	PAPER TONE		
GE	GENERAL	KJ	KITCHEN	LBS	LABORATORY	PV	POLYVINYL CHLORIDE		
GF	GENERAL	KK	KITCHEN	LBS	LABORATORY	PRE	PRECAST		
GH	GENERAL	KL	KITCHEN	LBS	LABORATORY	PF	POUR		
GI	GENERAL	KM	KITCHEN	LBS	LABORATORY	PI	PAINT		
GJ	GENERAL	KN	KITCHEN	LBS	LABORATORY	PTD	PAPER TONE		
GK	GENERAL	KO	KITCHEN	LBS	LABORATORY	PV	POLYVINYL CHLORIDE		
GL	GENERAL	KP	KITCHEN	LBS	LABORATORY	PRE	PRECAST		
GM	GENERAL	KQ	KITCHEN	LBS	LABORATORY	PF	POUR		
GN	GENERAL	KR	KITCHEN	LBS	LABORATORY	PI	PAINT		
GO	GENERAL	KS	KITCHEN	LBS	LABORATORY	PTD	PAPER TONE		
GP	GENERAL	KT	KITCHEN	LBS	LABORATORY	PV	POLYVINYL CHLORIDE		
GQ	GENERAL	KU	KITCHEN	LBS	LABORATORY	PRE	PRECAST		
GR	GENERAL	KV	KITCHEN	LBS	LABORATORY	PF	POUR		
GS	GENERAL	KW	KITCHEN	LBS	LABORATORY	PI	PAINT		
GT	GENERAL	KX							

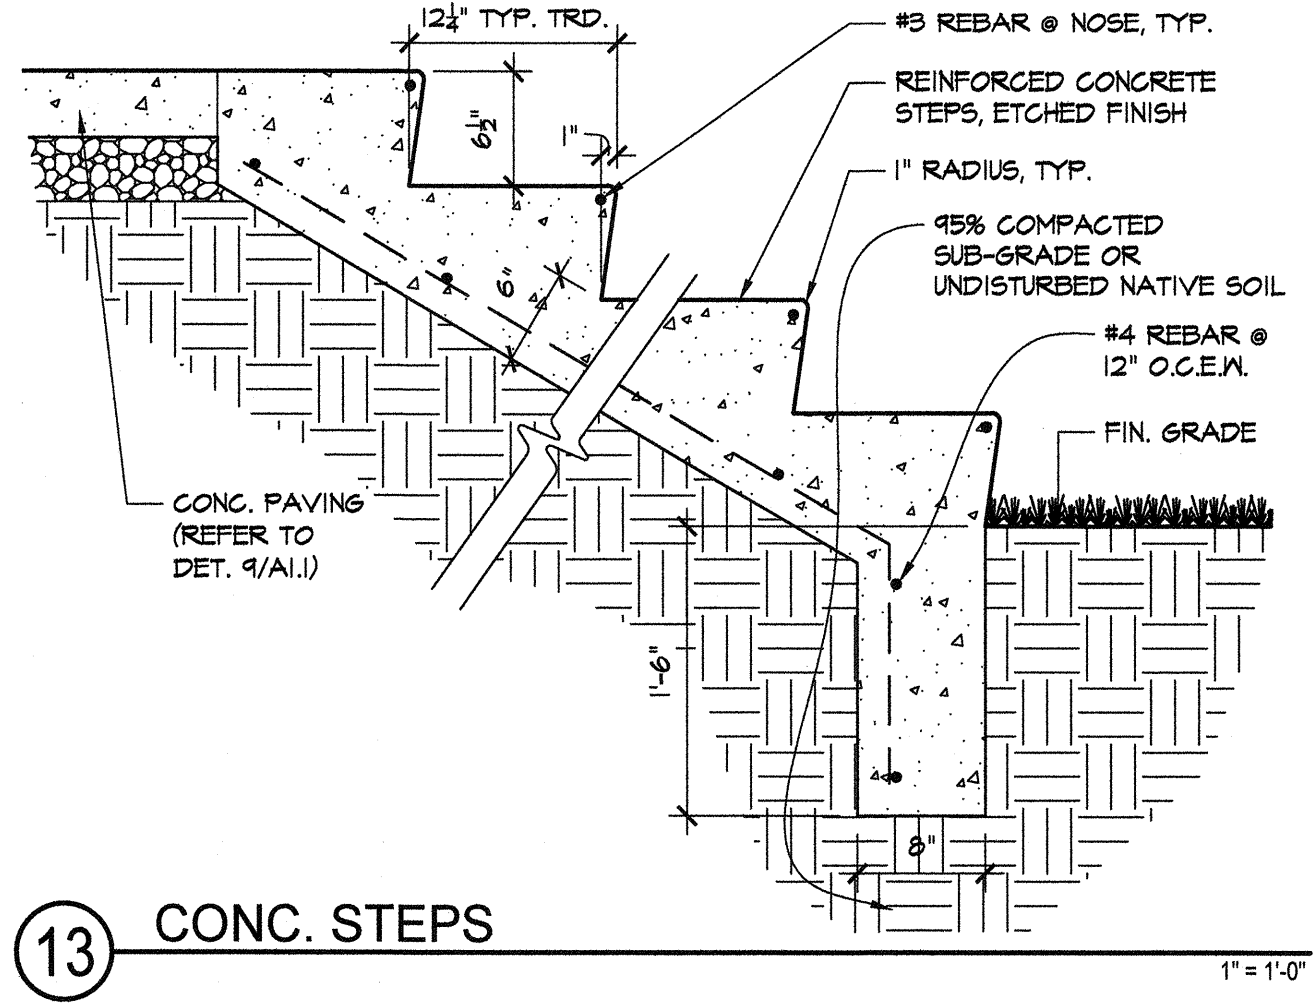

Fred Baxter & Associates
ARCHITECTURE
649 Fifth Street, Suite 203 Mukilteo, Washington 98275 fax (425) 348-3975 www.baxterarchitects.com

Date: 05.31.17 - Permit Submittal
11.13.17 - Plan Check #1
04.16.18 - Tree Notes Removal & Landscaping Note
06.05.18 - City Comments
06.05.18 - City Resubmittal

This document, and the ideas and designs incorporated herein, as an instrument of professional service, is the property of the architect and shall remain the property of the architect or in part, for any other project without the written authorization of the architect.

REVISION



RECEIVED
CITY OF MUKILTEO
JUN 5 2018

Zhang Family LLC
New Residence
7908 53rd Avenue West
Mukilteo, Washington 98275

A1.1

FLOOR PLAN NOTES

1. ALL EXTERIOR WALLS TO BE 2X6 STUD FRAMING @ 16" O.C. AND ALL INTERIOR PARTITIONS TO BE 2X4 FRAMING, UNLESS NOTED OTHERWISE.
2. FOR WINDOW AND EXTERIOR GLASS DOOR SIZES AND TYPES: SEE EXTERIOR ELEVATIONS, GLAZING SCHEDULE (SHT. A3.2) AND SPECIFICATIONS.
3. FOR OPAQUE EXTERIOR DOORS (LESS THAN 50% GLAZING) AND ALL INTERIOR DOORS, SEE FLOOR PLAN AND DOOR SCHEDULE (SHT. A2.3) AND SPECIFICATIONS.
4. ALL GRID LINES ARE TO AND FACE OF EXTERIOR FRAMING (STUDS) AND TO CENTER OF INTERIOR COLUMNS, EXCEPT WHEN NOTED AS FACE OF INTERIOR PARTITION (FRAMING) AND COLUMN.
5. SEE 1/8" SCALE PLANS FOR OVERALL EXTERIOR DIMENSIONS AND 1/4" SCALE FLOOR PLANS FOR DETAILED INTERIOR DIMENSIONS.
6. INSTALL ACOUSTICAL INSULATION AROUND PERIMETER WALLS OF ALL BATHROOMS AND BEDROOM SUITES AS SPECIFIED FOR ACOUSTICAL PARTITIONS.
7. SEE SHEET A2.3 FOR SCHEDULE OF FINISHES.
8. SEE STRUCTURAL DRAWINGS FOR LOCATIONS AND DESIGNATIONS OF SHEARWALLS. WHEN A WALL OR PARTITION HAS SHEATHING ON AN INTERIOR FACE, THE ENTIRE WALL SURFACE IN THAT PLANE SHALL BE FURRED FLUSH WITH SHEARWALL SHEATHING.
9. DIMENSIONS ON THE ARCHITECTURAL DRAWINGS GOVERN OVER DIMENSIONS ON THE STRUCTURAL DRAWINGS AND SHOULD BE USED TO LAY OUT THE BUILDING. NOTIFY ARCHITECT OF ANY DISCREPANCIES THAT ARE DISCOVERED.
10. SEE GENERAL NOTES AND SPECIFICATIONS FOR FURTHER INFORMATION.

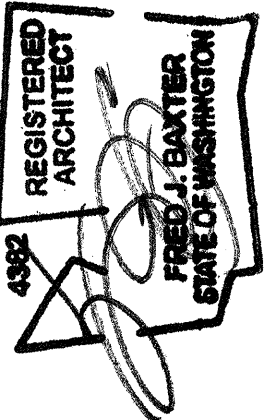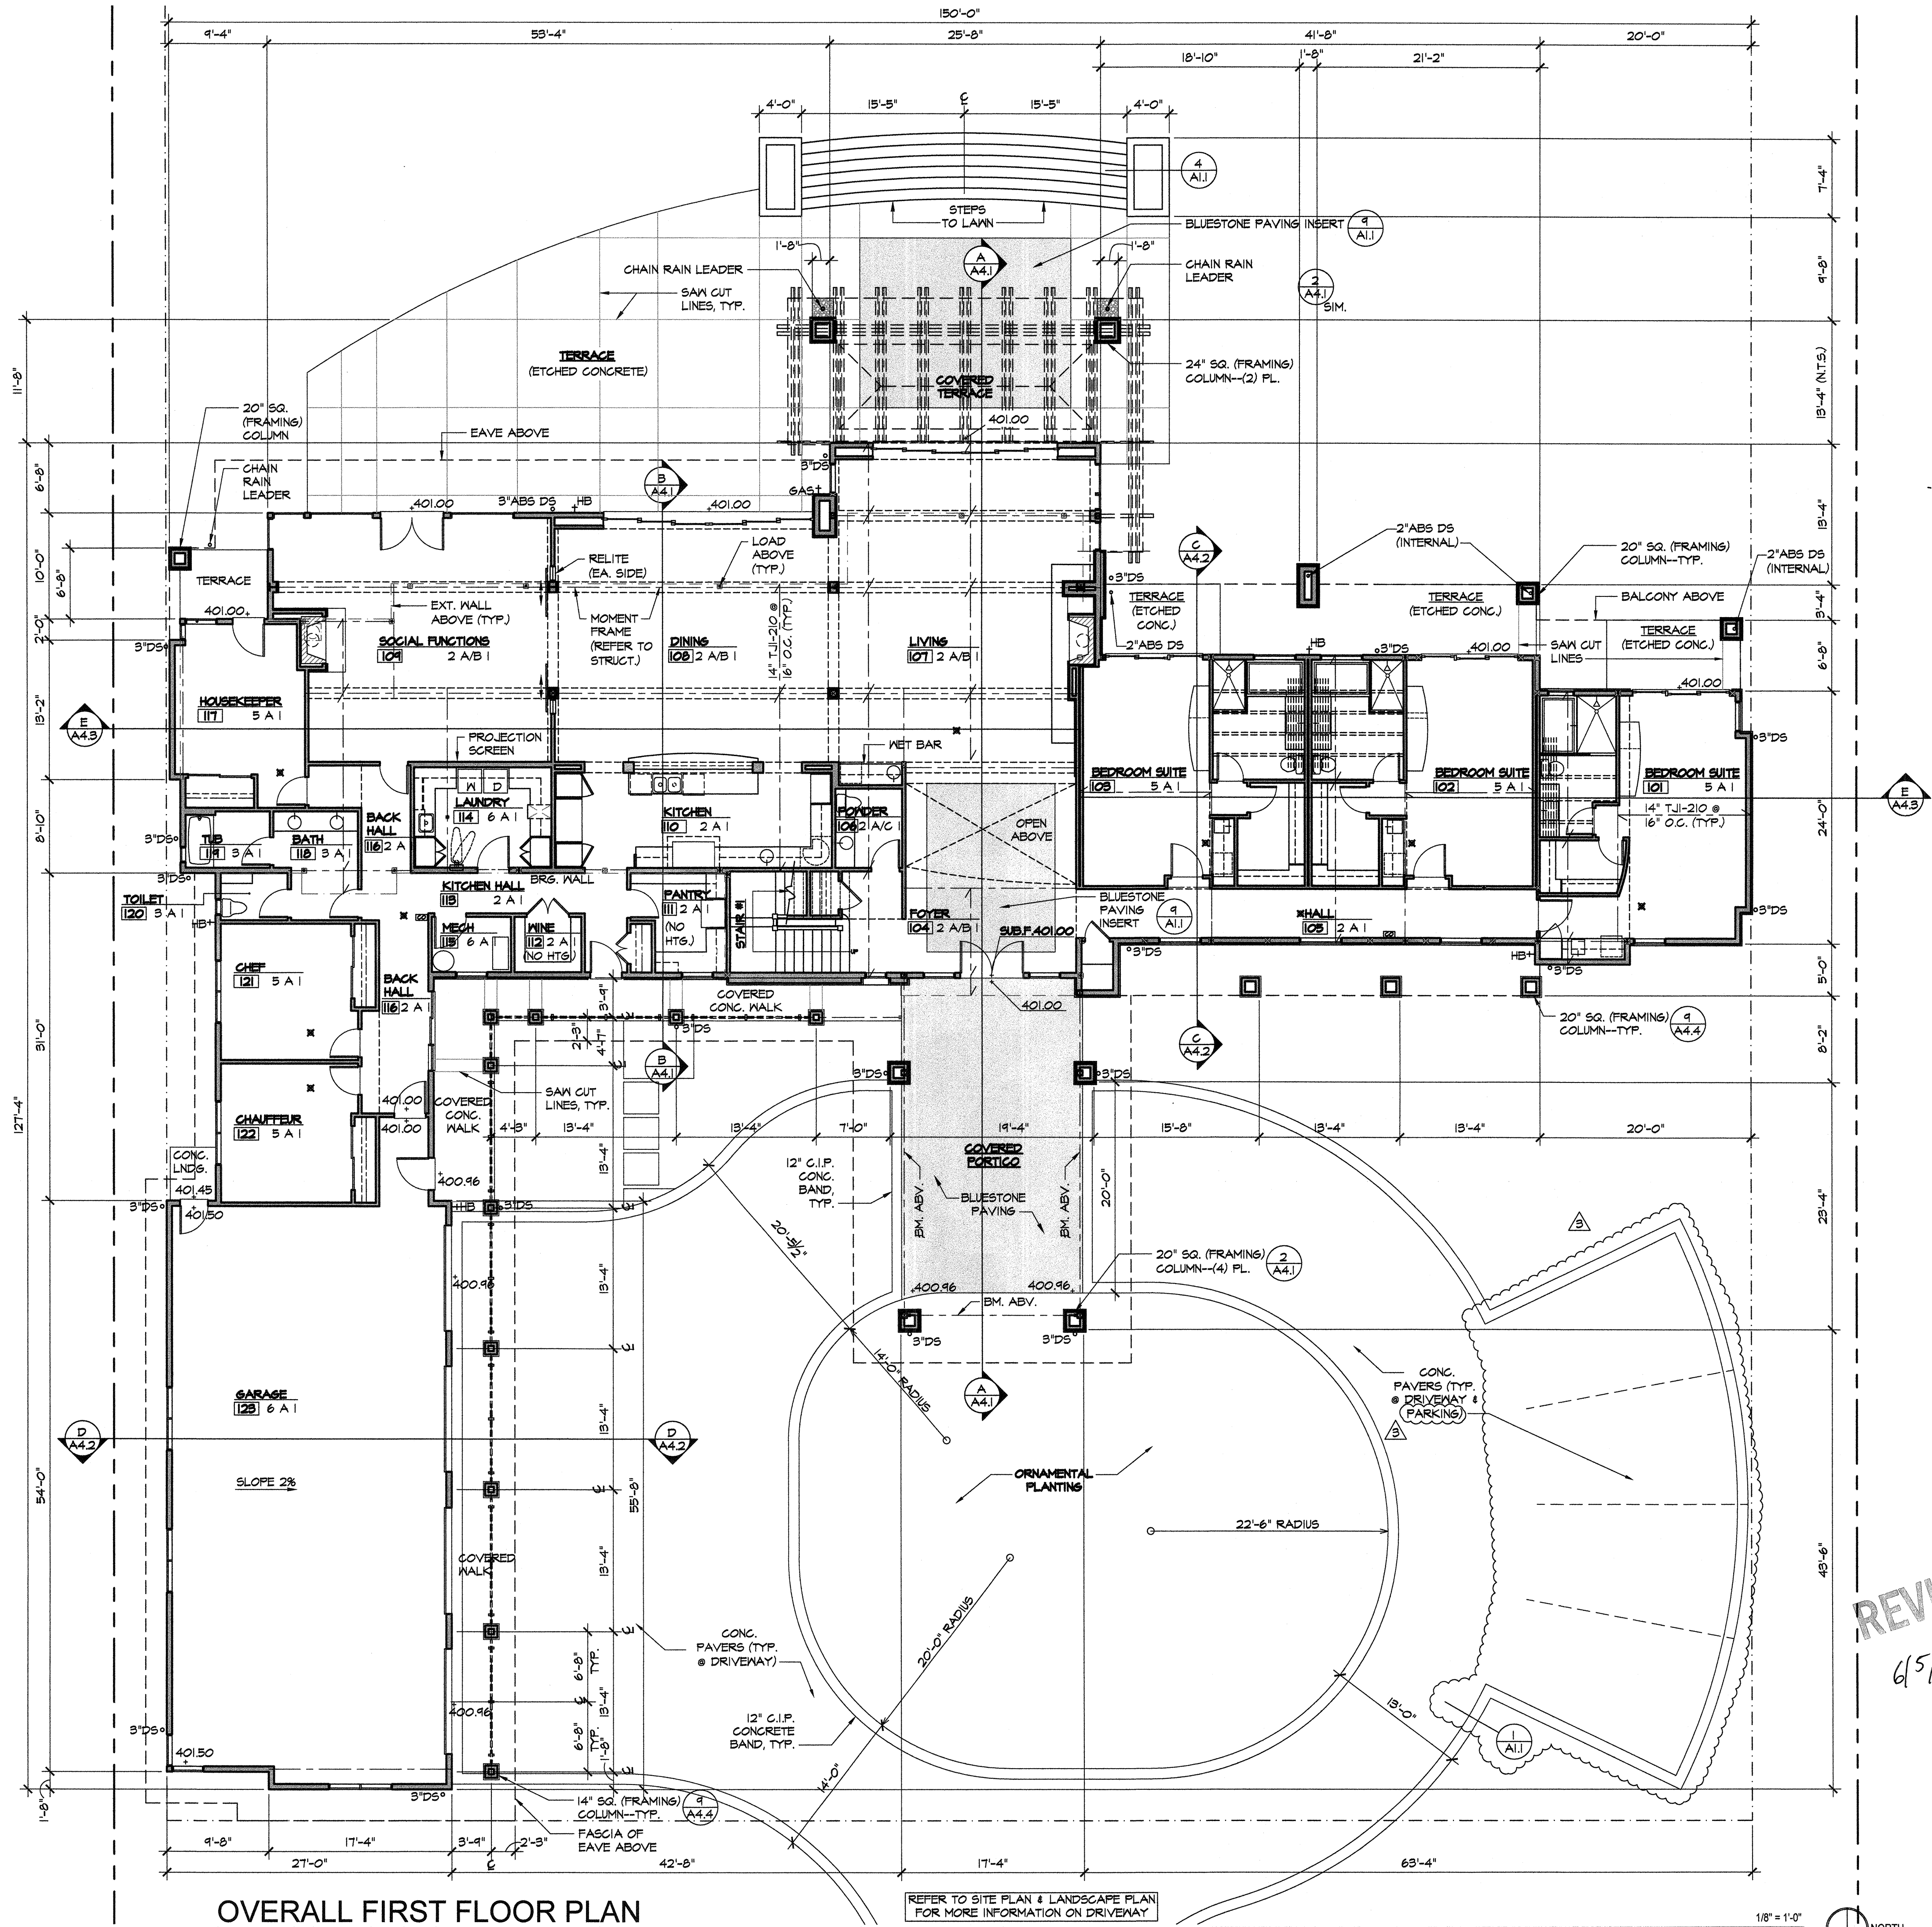

ARCHITECTURE
Fred Baxter & Associates
 649 Fifth Street, Suite 203 Mukilteo, Washington 98275 fax (425) 348-3975 www.baxterarchitects.com





Date: 05.31.17 - Permit Submittal
 04.16.19 CONC. FAVERS (CITY REV.)
 06.05.18 - City Resubmittal

This document, and the ideas and designs incorporated herein, as an instrument of the professional service, is the property of the architect and is not to be used, in whole or in part, for any other project without the written authorization of the architect.

Zhang Family LLC
New Residence
 7908 53rd Avenue West
 Mukilteo, Washington 98275

A2.1

REVISION
 6/5/18

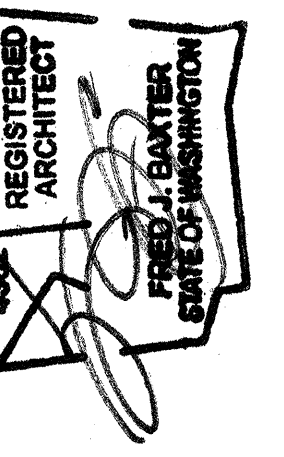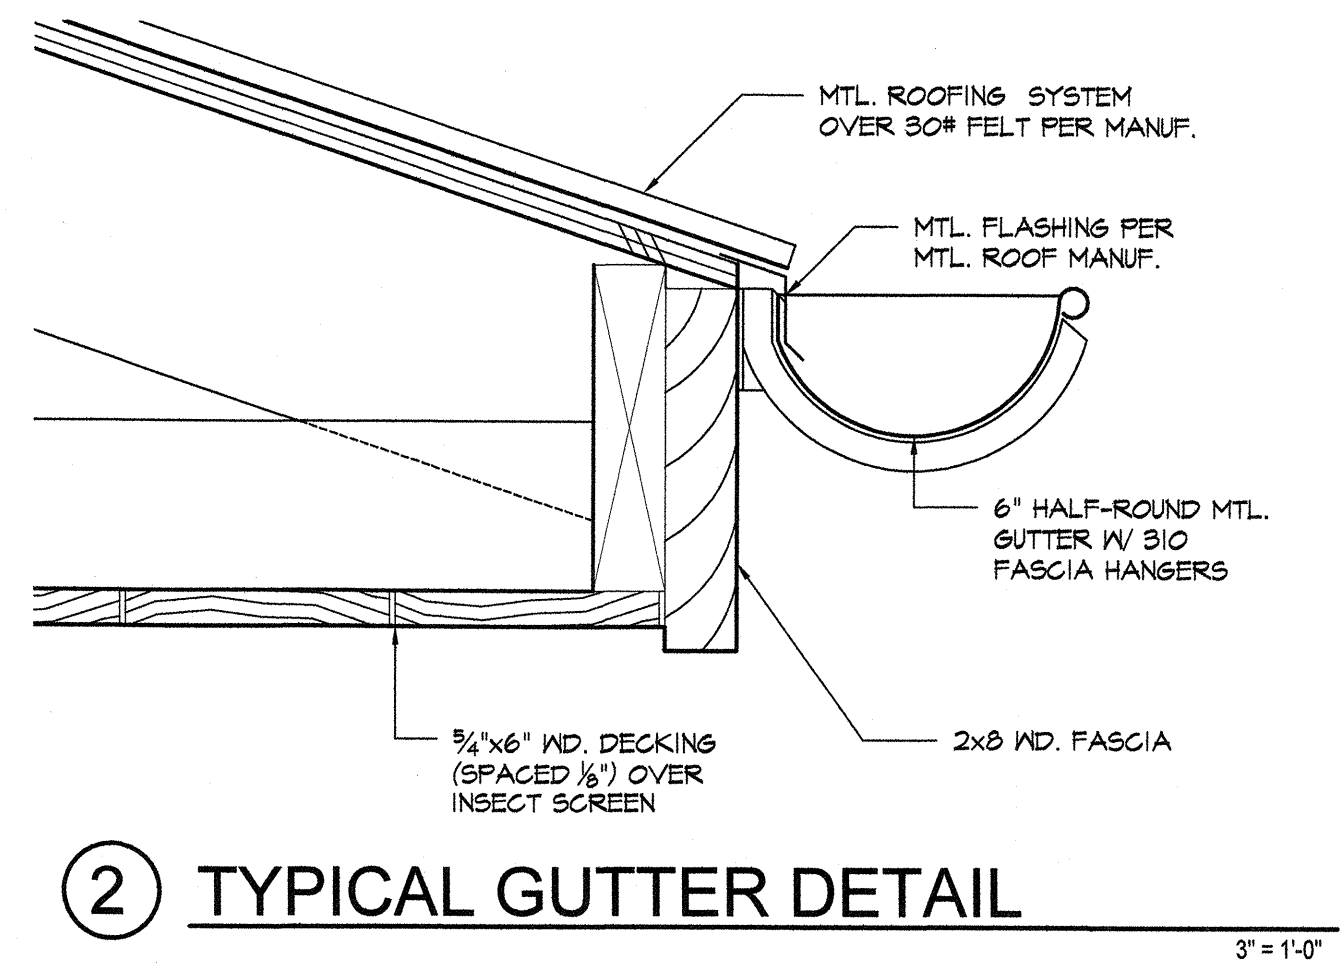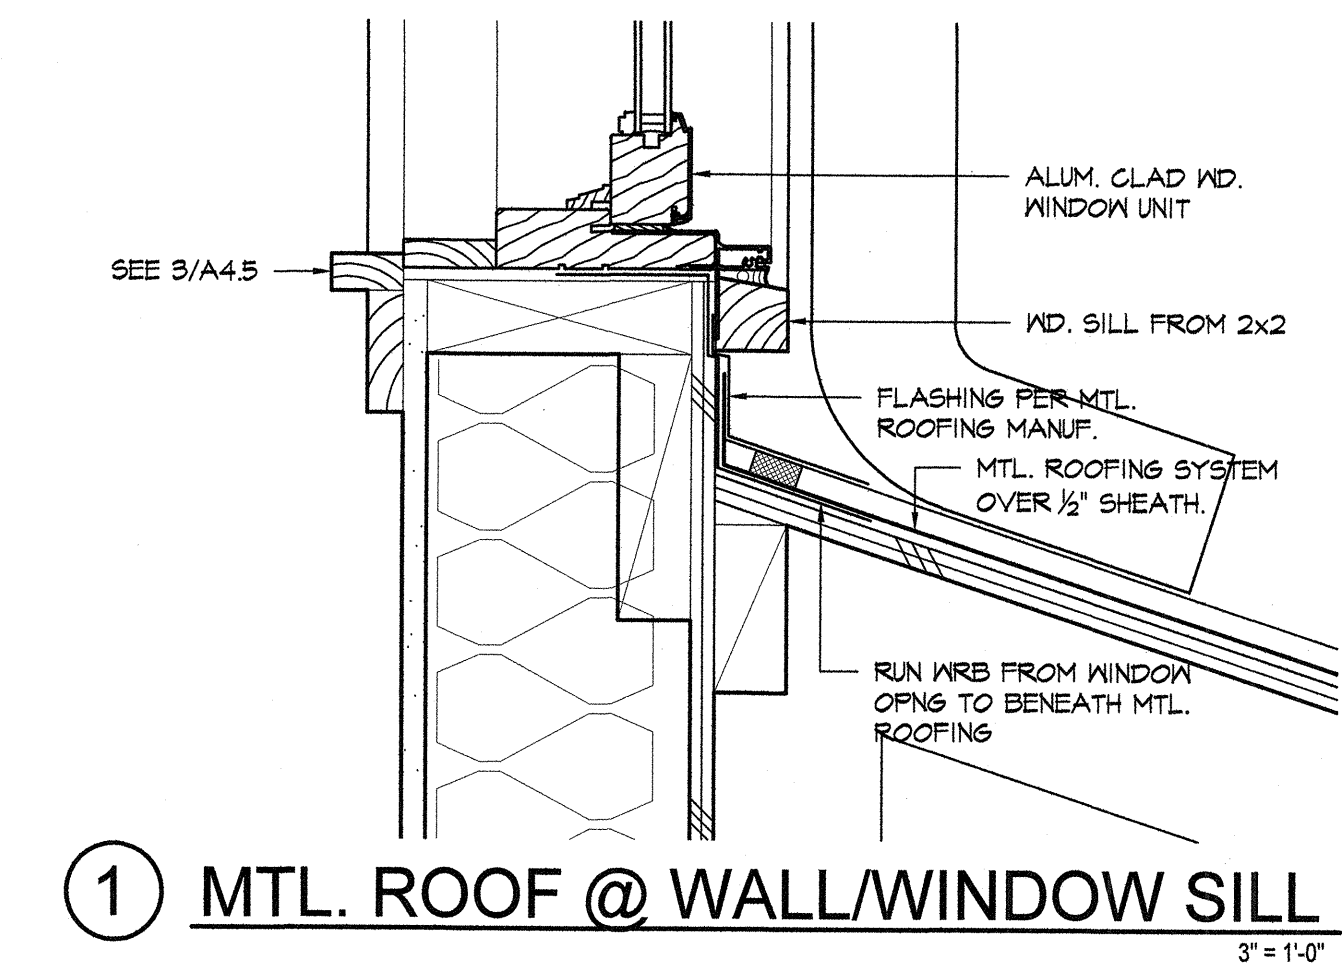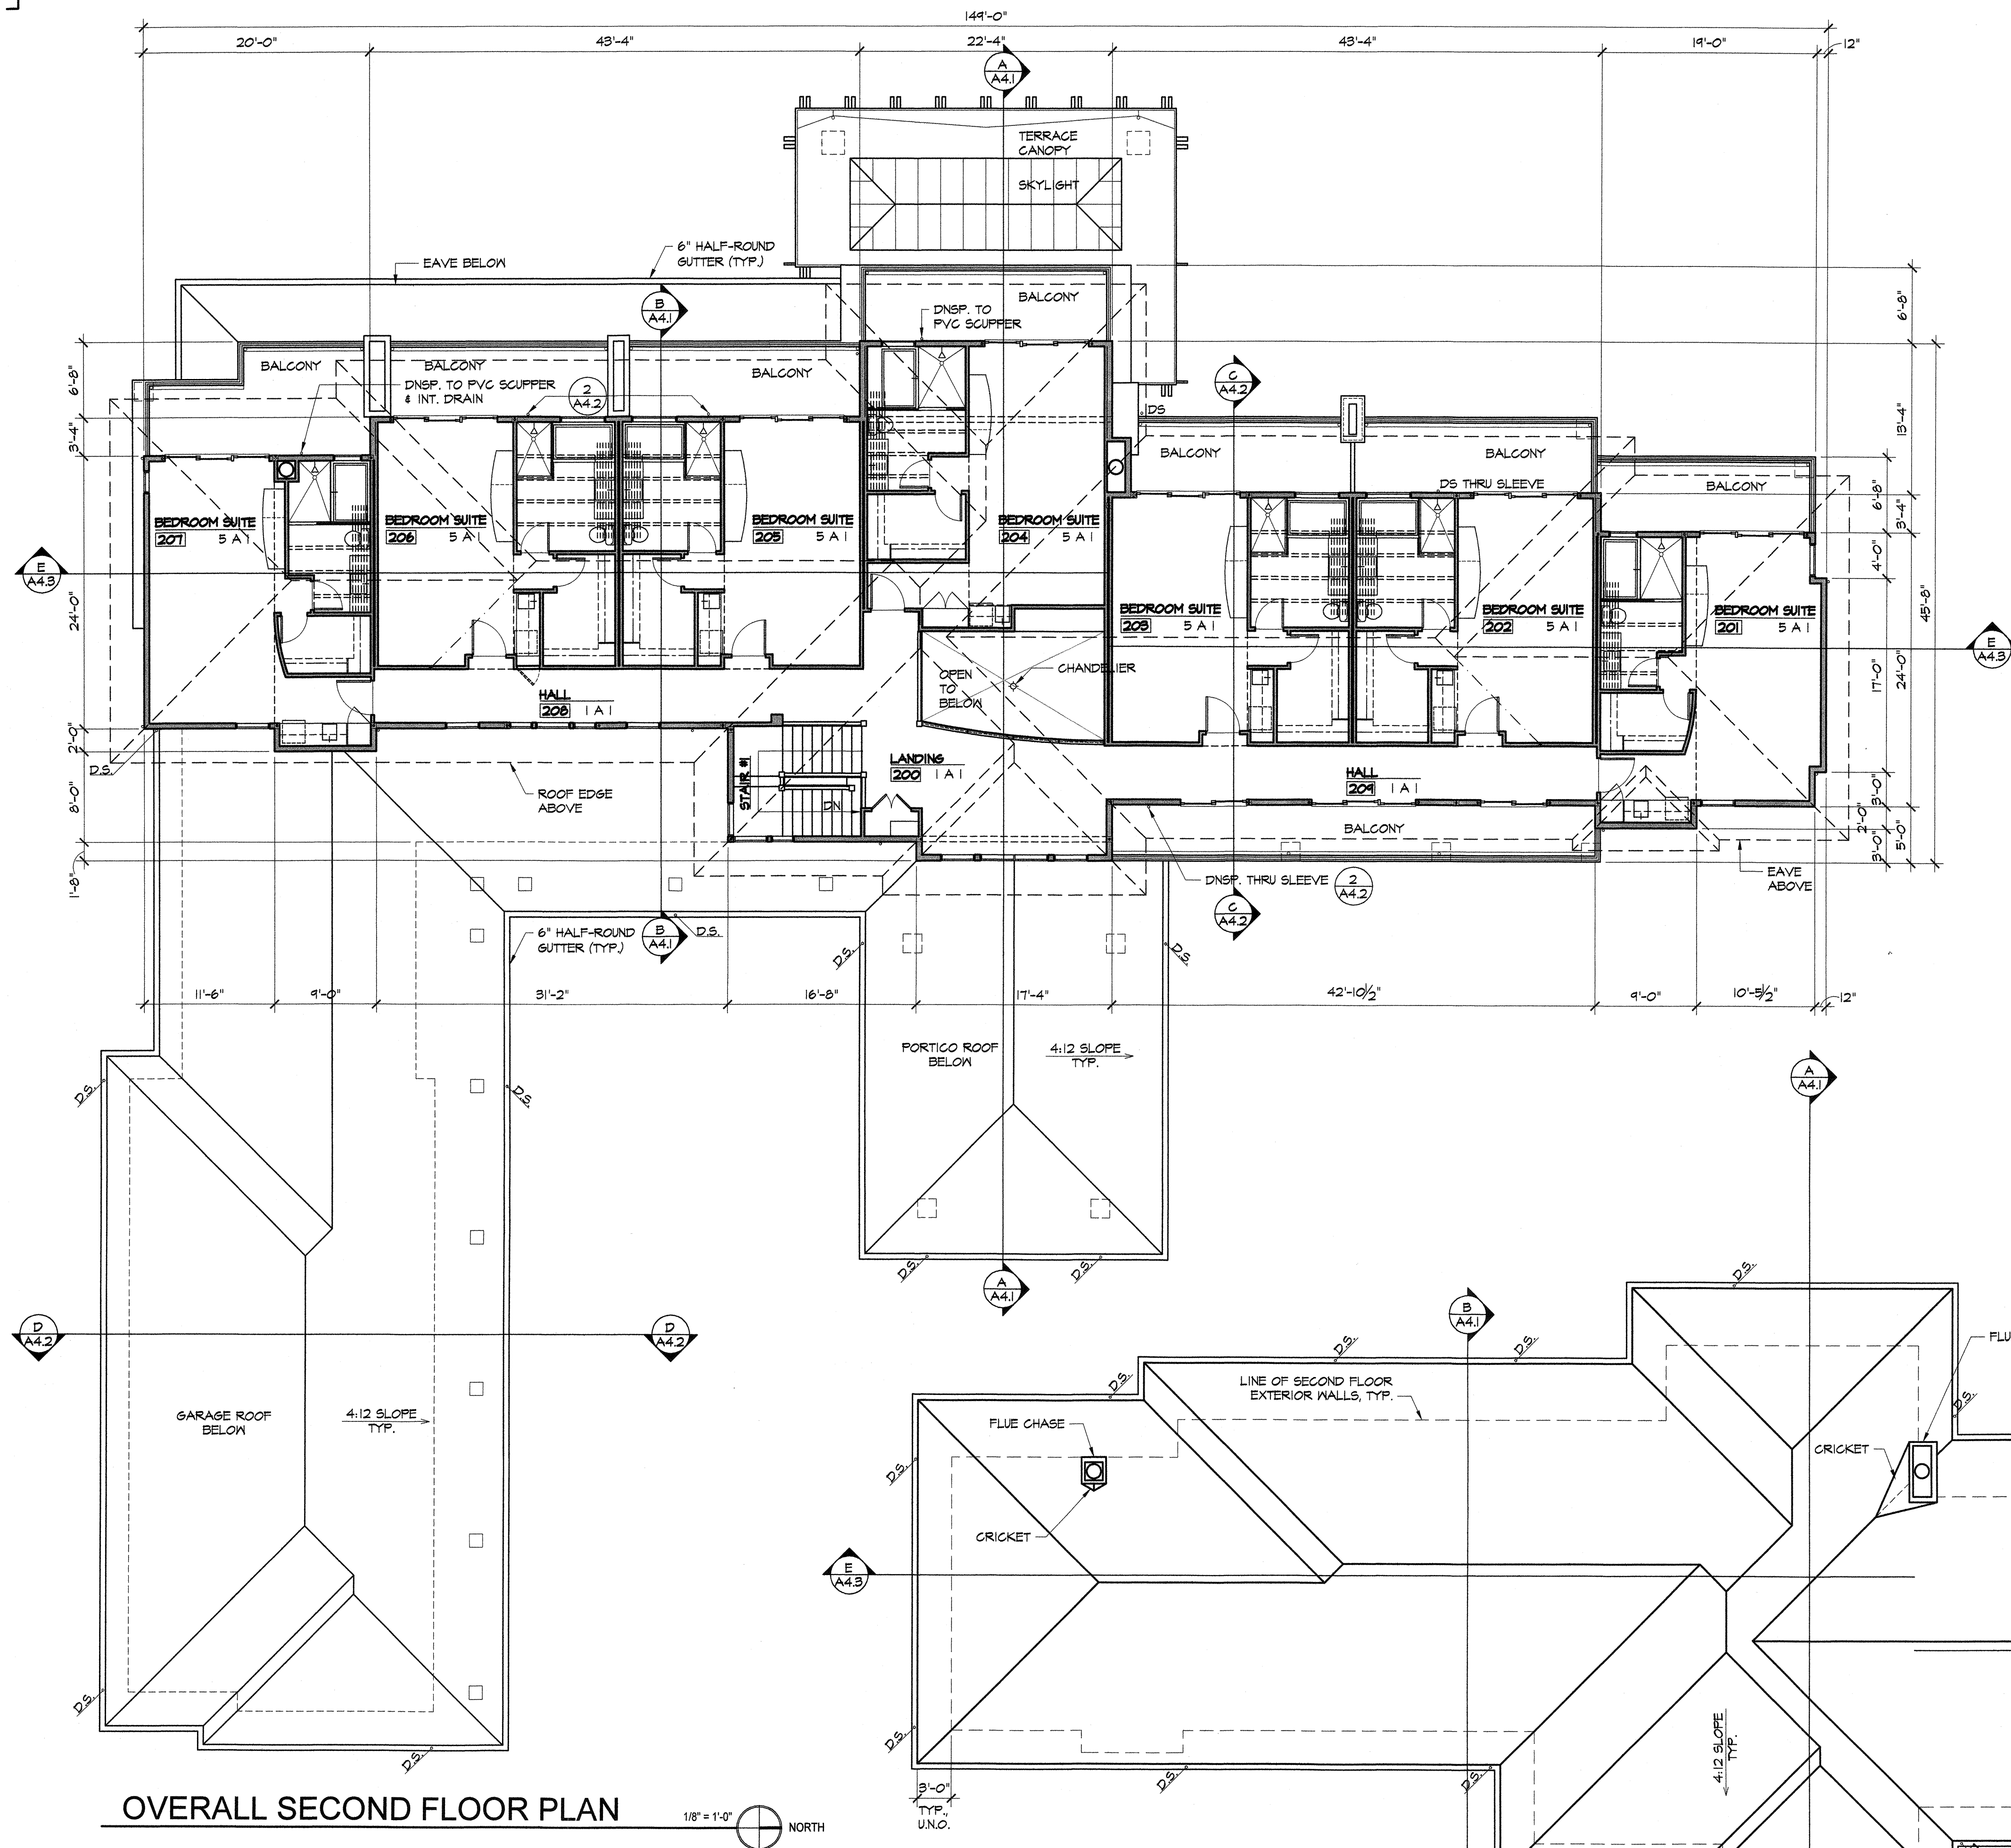

Fred Baxter & Associates
ARCHITECTURE
649 Fifth Street, Suite 203 Mukiteo, Washington 98275 (425) 348-3975 fax (425) 353-0205 www.baxterarchitects.com


Date: 05.31.17 - Permit Submittal

This document, and the ideas and designs incorporated herein, as an instrument of professional service, is the property of the architect and is not to be used, in whole or in part, for any other project without the written authorization of the architect.

Zhang Family LLC
New Residence
7908 53rd Avenue West
Mukiteo, Washington 98275

RECEIVED
JUN 6 2017
CITY OF MUKITEO

A2.2

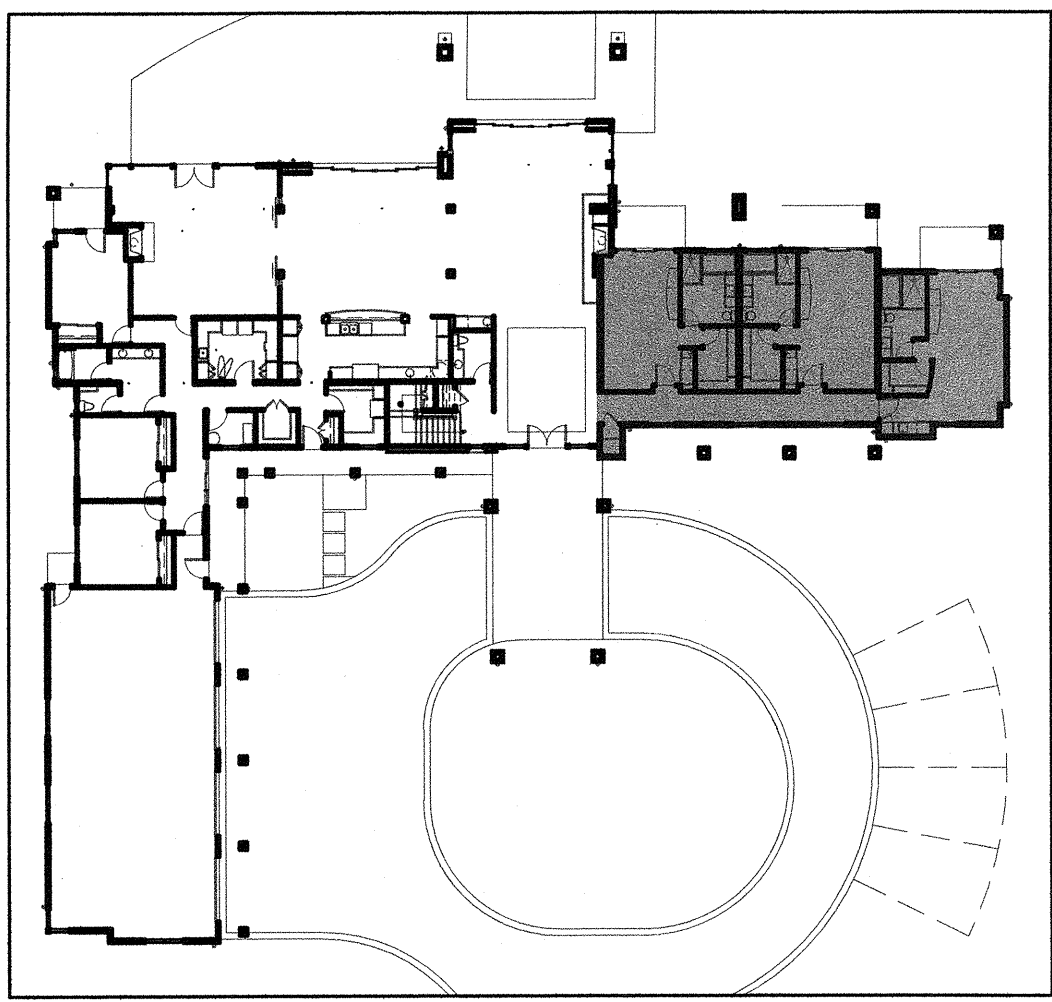


KEY PLAN

DOOR SCHEDULE

Door #	Type	Size	Door	Frame	HDWR GROUP	Remarks
		W H T	Mat'l	Fin	Mat'l	Fin
FIRST FLOOR						
101A	A	3'-0" 8'-0"	1 3/8" WD	Transp.	WD	Transp.
101B						
101C	A	2'-6" 7'-0"	1 3/8" WD	Transp.	WD	Transp.
101D	A	2'-6" 7'-0"	1 3/8" WD	Transp.	WD	Transp.
102A	A	3'-0" 8'-0"	1 3/8" WD	Transp.	WD	Transp.
102B						
102C	A	2'-6" 7'-0"	1 3/8" WD	Transp.	WD	Transp.
102D	A	2'-6" 7'-0"	1 3/8" WD	Transp.	WD	Transp.
103A	A	3'-0" 8'-0"	1 3/8" WD	Transp.	WD	Transp.
103B						
103C	A	2'-6" 7'-0"	1 3/8" WD	Transp.	WD	Transp.
103D	A	2'-6" 7'-0"	1 3/8" WD	Transp.	WD	Transp.
104A						
104B	A	3'-0" 8'-0"	1 3/8" WD	Transp.	WD	Transp.
105A	A	2'-6" 8'-0"	1 3/8" WD	Transp.	WD	Transp.
106A	A	3'-0" 8'-0"	1 3/8" WD	Transp.	WD	Transp.
107A						
108A						
109A						
111A	A	3'-0" 8'-0"	1 3/8" WD	Transp.	WD	Transp.
112A	B	4'-0" 8'-0"	1 3/8" WD	Transp.	WD	Transp.
113A						
113B	B	3'-0" 8'-0"	1 3/8" WD	Transp.	WD	Transp.
114A	A	3'-0" 8'-0"	1 3/8" WD	Transp.	WD	Transp.
115A	A	3'-0" 8'-0"	1 3/8" WD	Transp.	WD	Transp.
116A	A	3'-0" 8'-0"	1 3/8" WD	Transp.	WD	Transp.
116B						
116C	A	3'-0" 8'-0"	1 3/8" WD	Transp.	WD	Transp.
117A	A	3'-0" 8'-0"	1 3/8" WD	Transp.	WD	Transp.
117B	B	6'-0" 8'-0"	1 3/8" WD	Transp.	WD	Transp.
117C						
DOOR TYPES

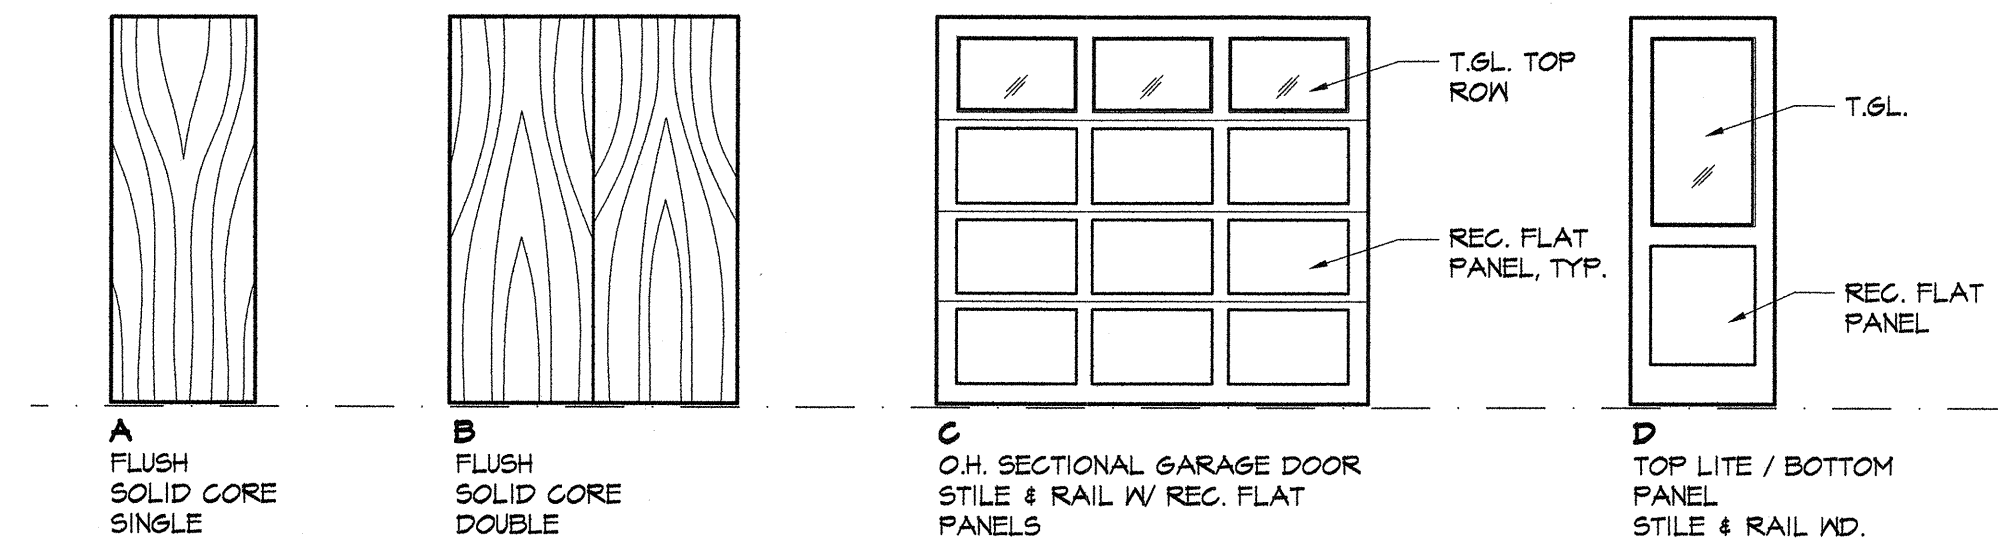



SCHEDULE OF FINISHES

Schedule of Finishes


Floor			Base			Wall			Ceiling		
Mark	Material	Finish	Material	Finish	Mark	Material	Finish	Mark	Material	Finish	Mark
1	Hdwd.	Swedish	Wood	Transp.	A	GW B	Paint	1	GW B	Paint	
2	Conc. Topping	Polished	Wood	Transp.	B	Wd. Panel	Transp.	2			
3	Tile	Sealer	Wood	Transp.	C	Tile	Sealer				
4	Vinyl		Rubber								
5	Carpet		Wood	Transp.							
6	Conc.	Sealer	Rubber								

Notes:
See Specifications for detailed requirements for finish materials scheduled.
See Floor Plans for finish designations noted below room names. See example below.

EXAMPLE

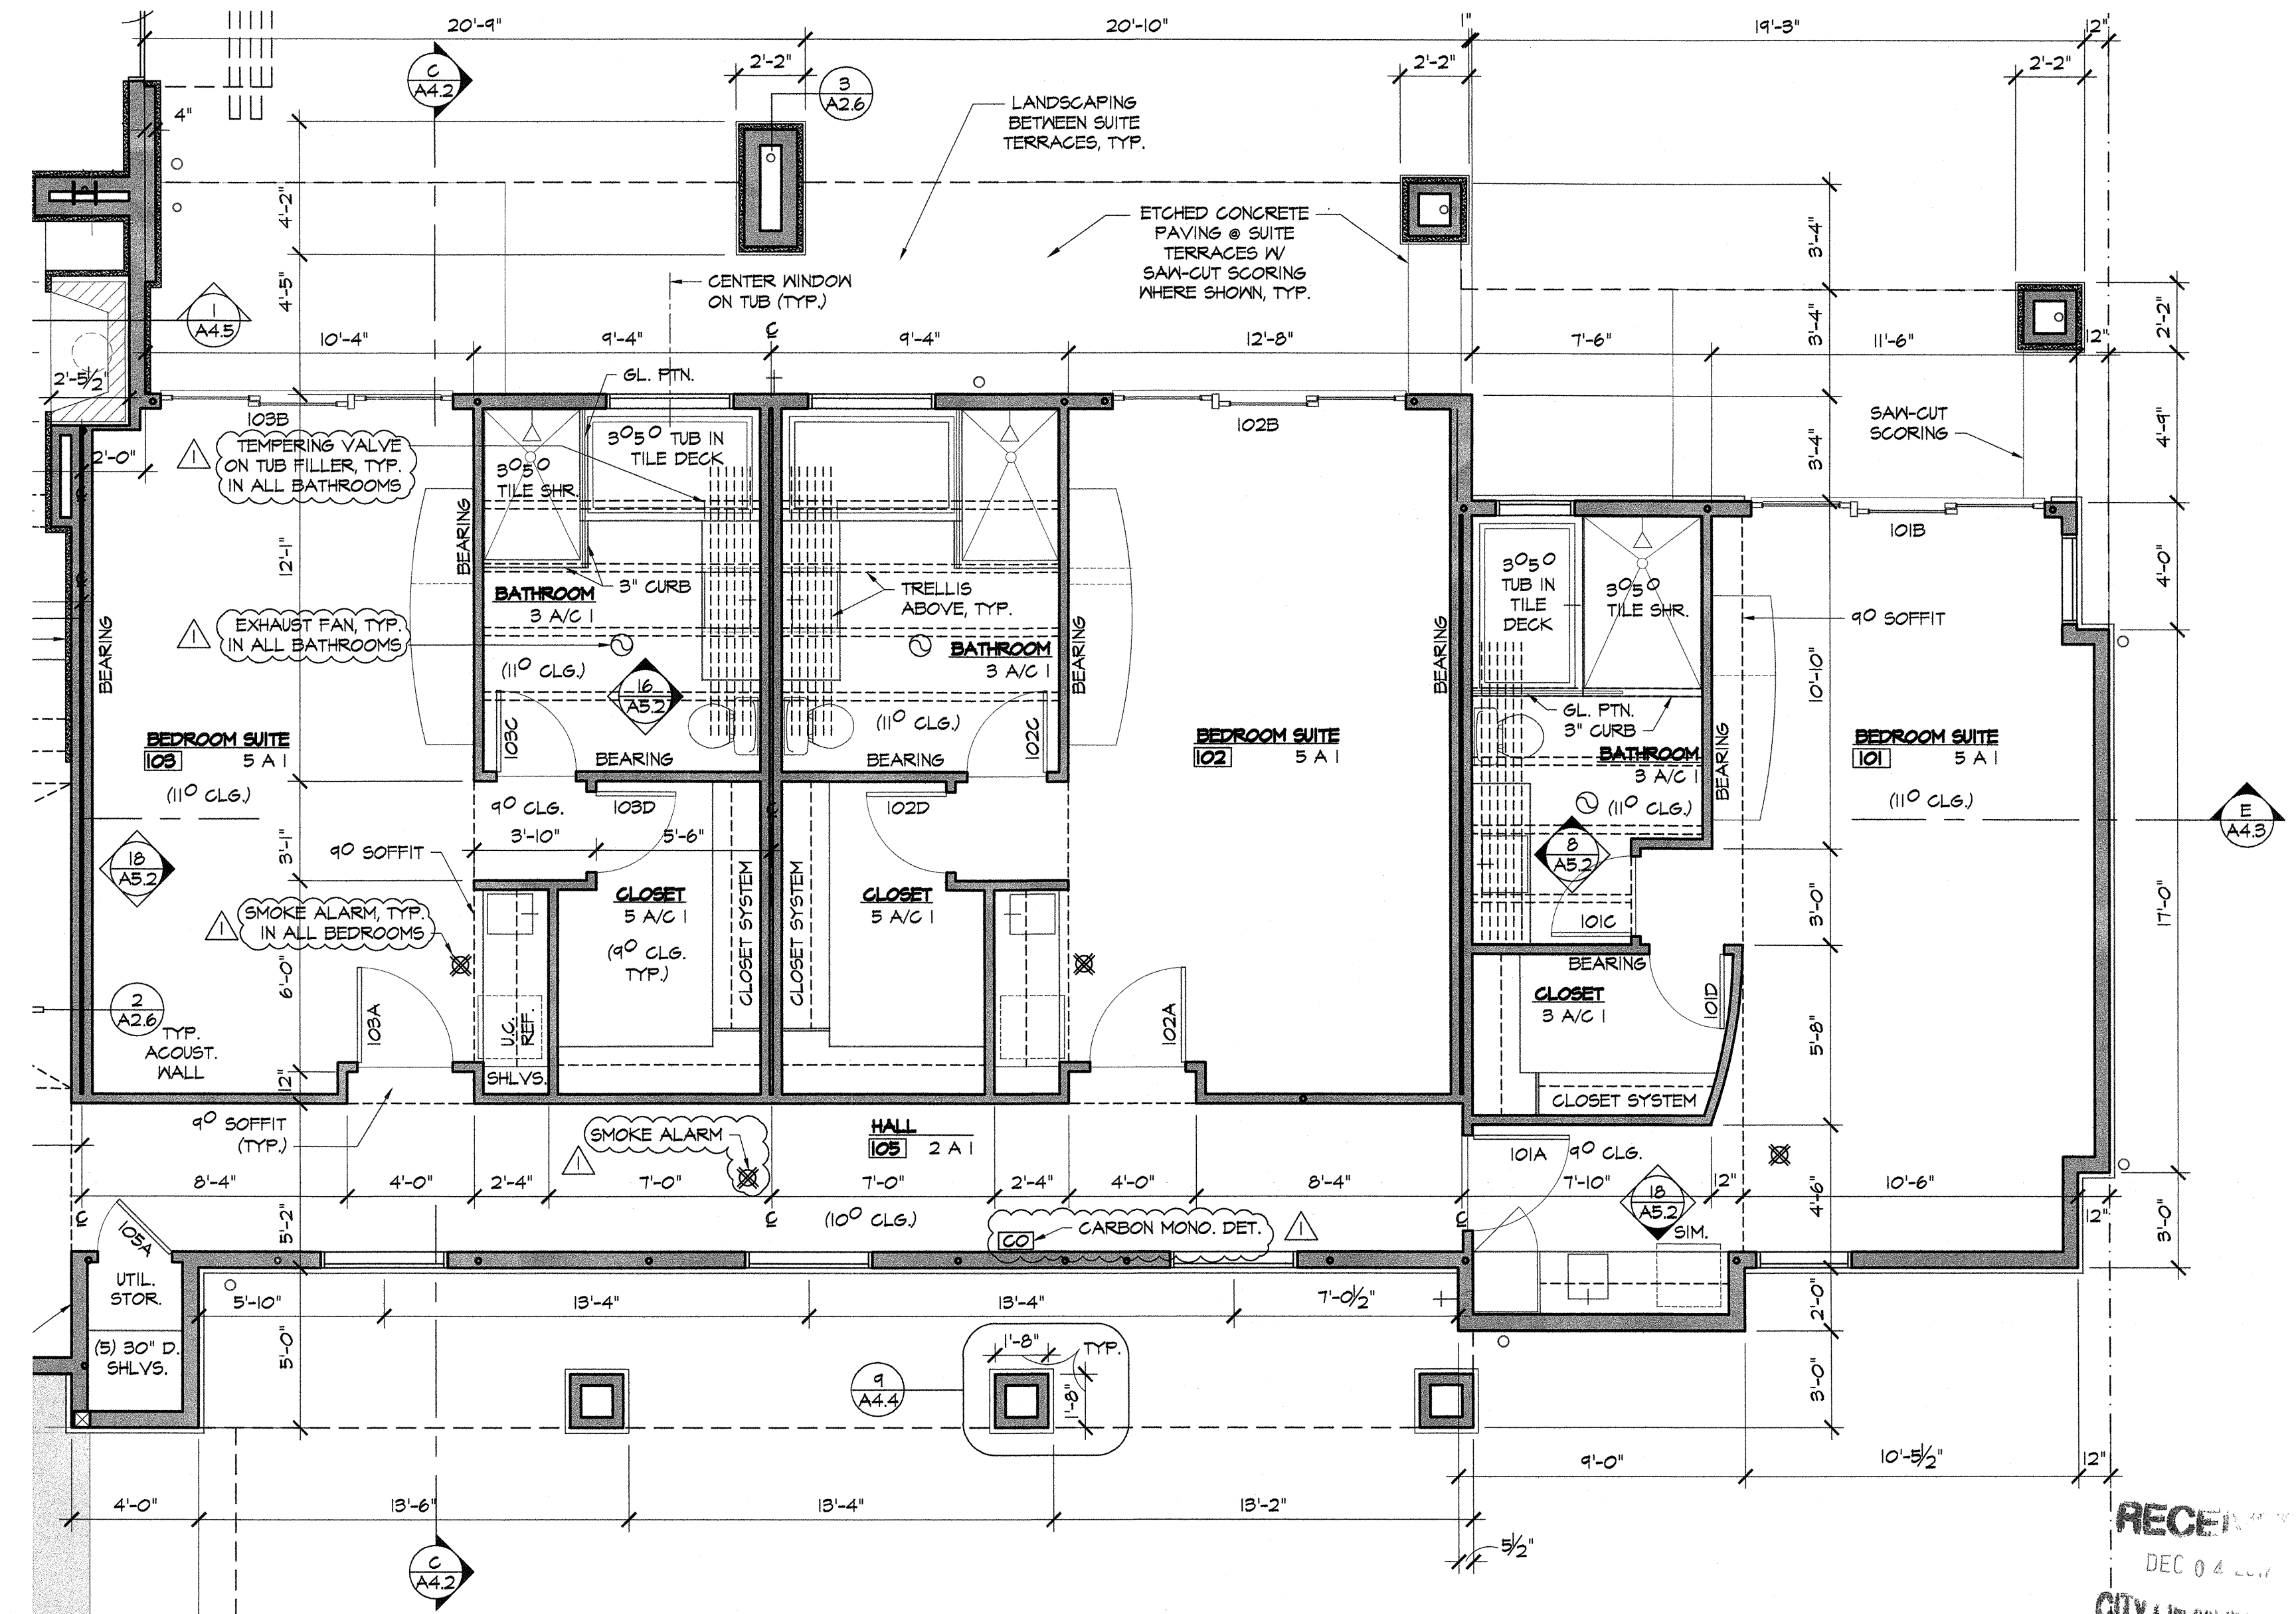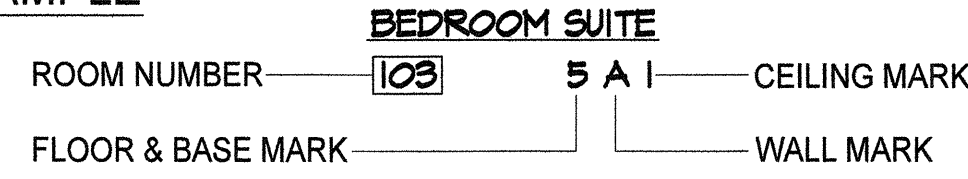

FIRST FLOOR PLAN--NORTH WING SEE SUITE 103 FOR TYP. NOTES

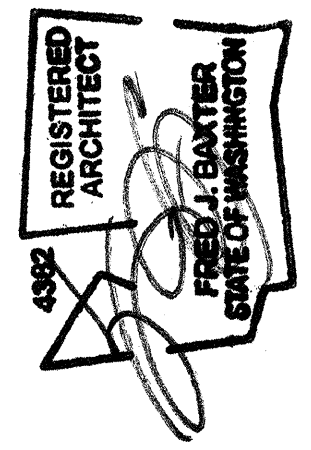


ARCHITECTURE
Fred Baxter & Associates


Date: 05.31.17 - Permit Submittal
11.13.17 - Plan Check #1
This document, and the ideas and designs incorporated herein, as an instrument of professional service, is the property of the architect and is not to be used, in whole or in part, for any other project without the written authorization of the architect.

Zhang Family LLC
New Residence
7908 53rd Avenue West
Mukilteo, Washington 98275


A2.3

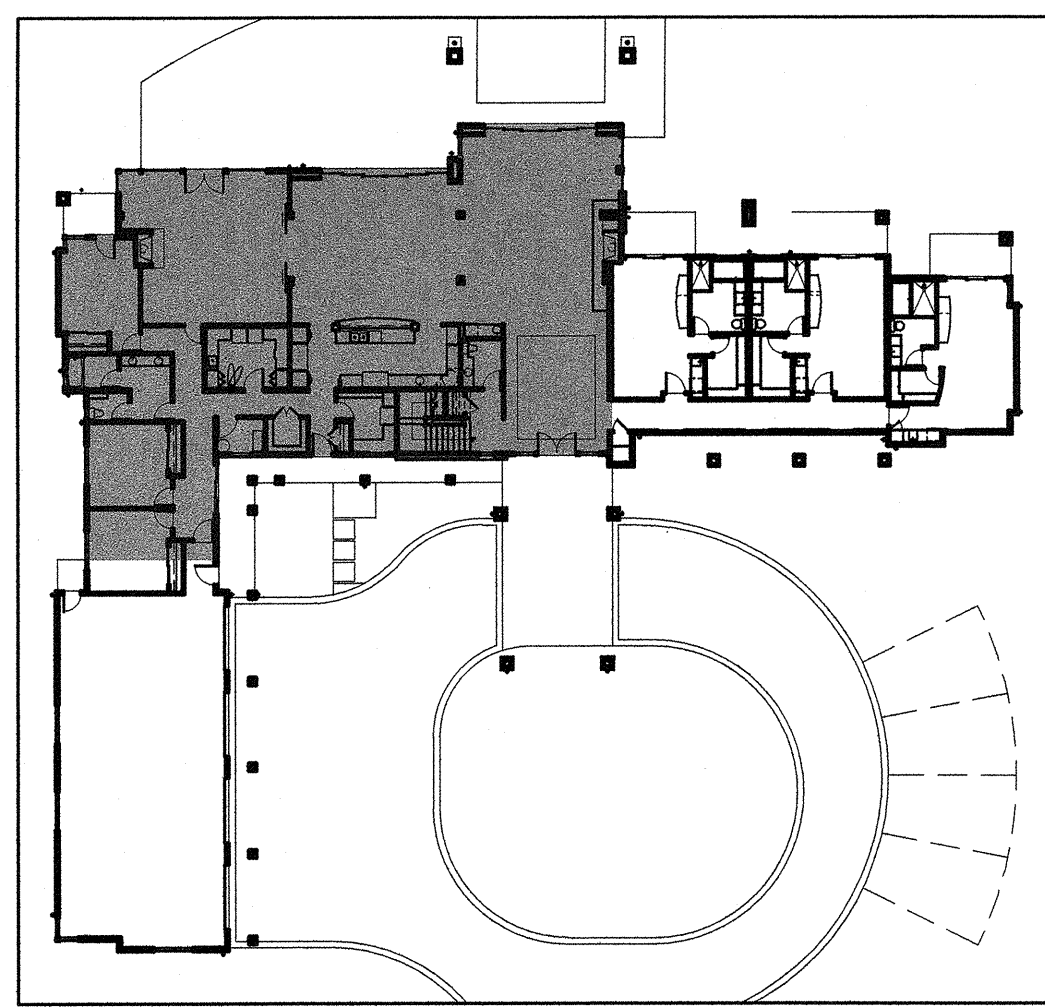

KEY PLAN

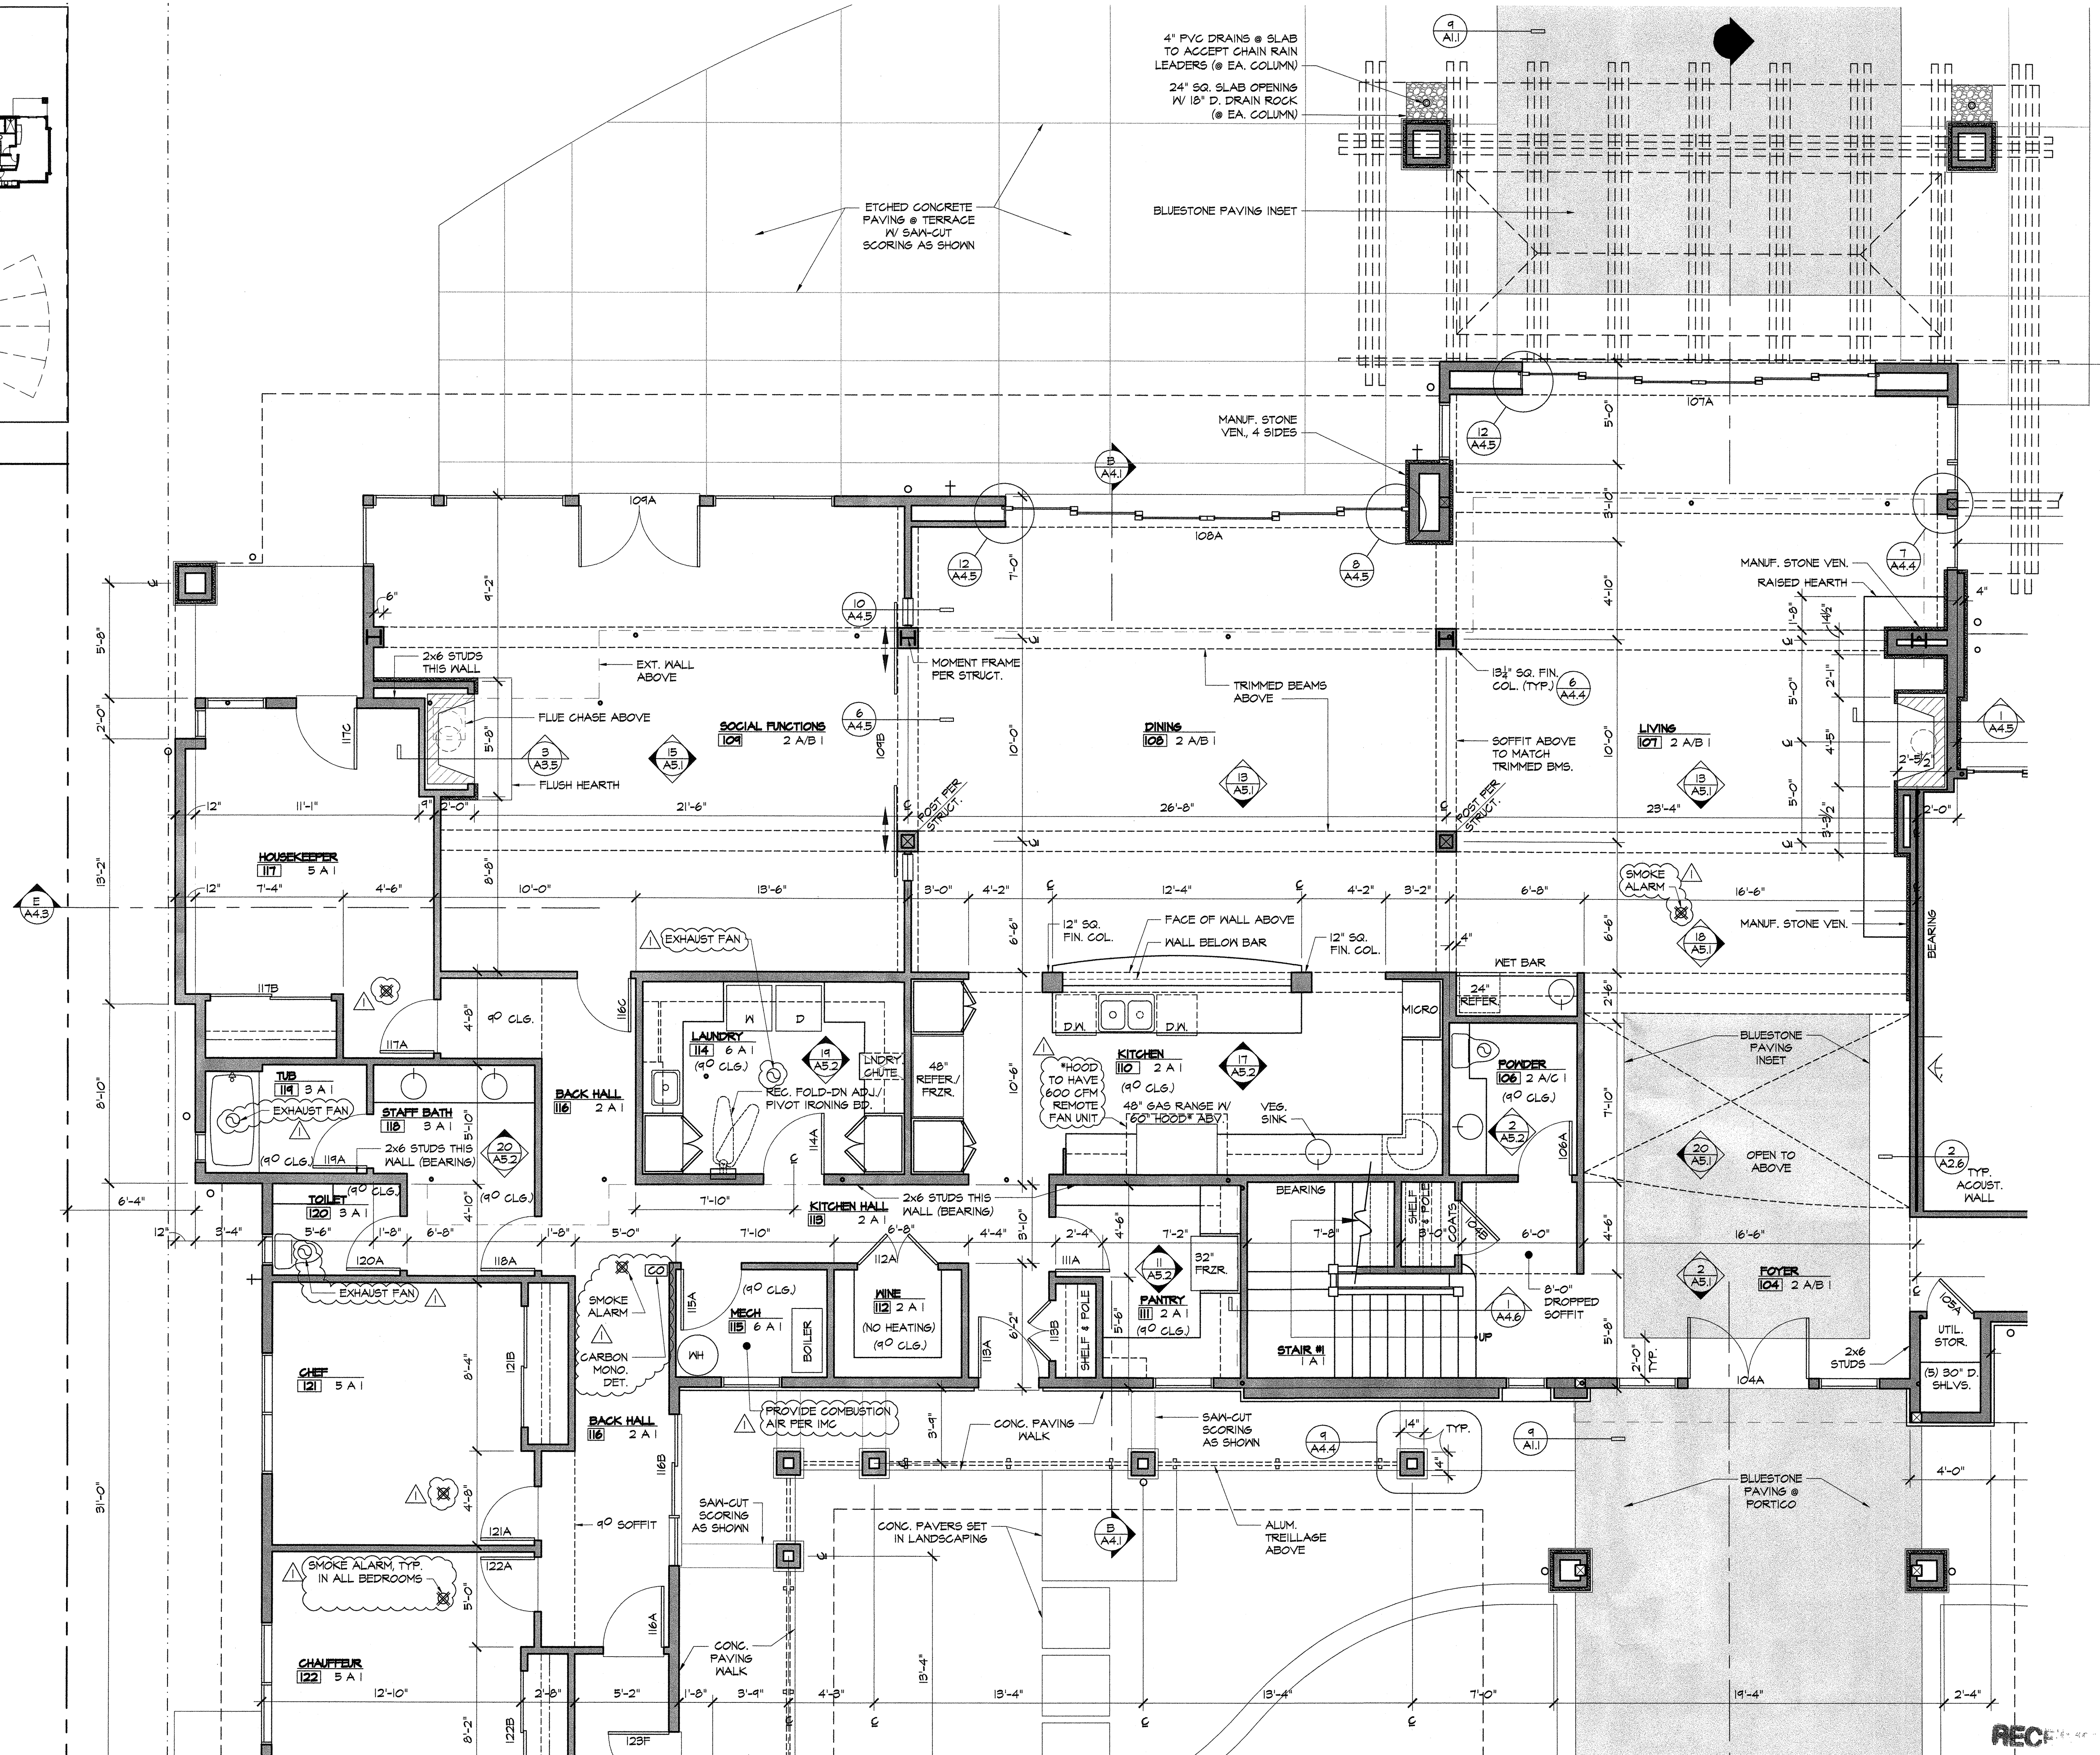

FIRST FLOOR PLAN--CENTRAL AND SOUTH AREA

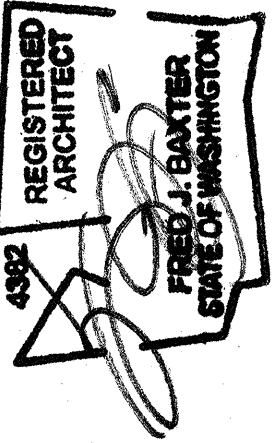


ARCHITECTURE
Fred Baxter & Associates


Date: 05.31.17 - Permit Submittal
11.13.17 - Plan Check #1

This document, and the ideas and designs incorporated herein, as an instrument of professional service, is the property of the architect and is not to be used, copied, or reproduced in any form without the written authorization of the architect.


Zhang Family LLC
New Residence
7908 53rd Avenue West
Mukilteo, Washington 98275

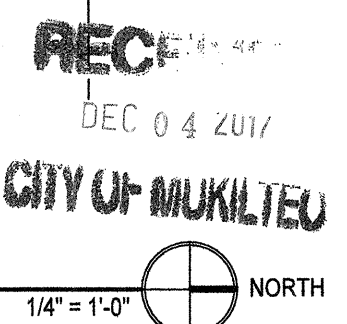



A2.4

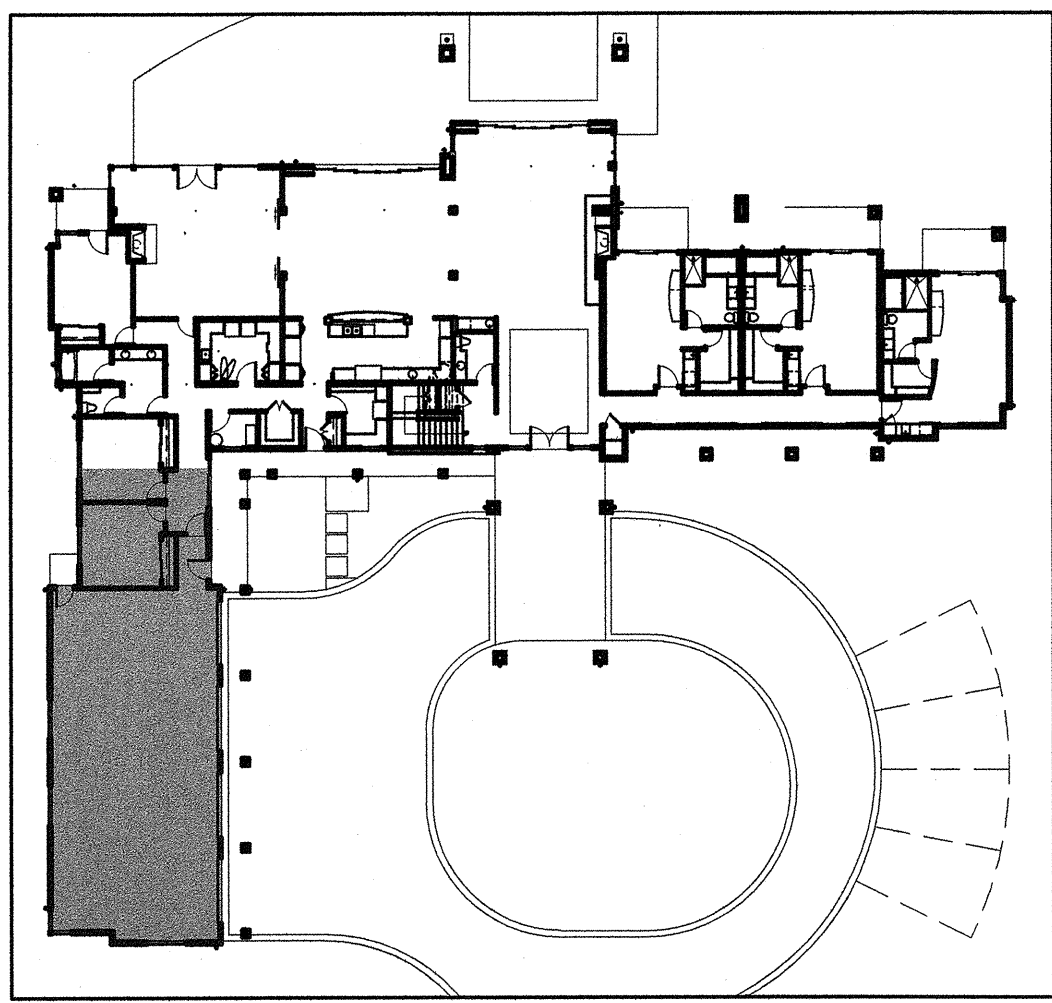

KEY PLAN

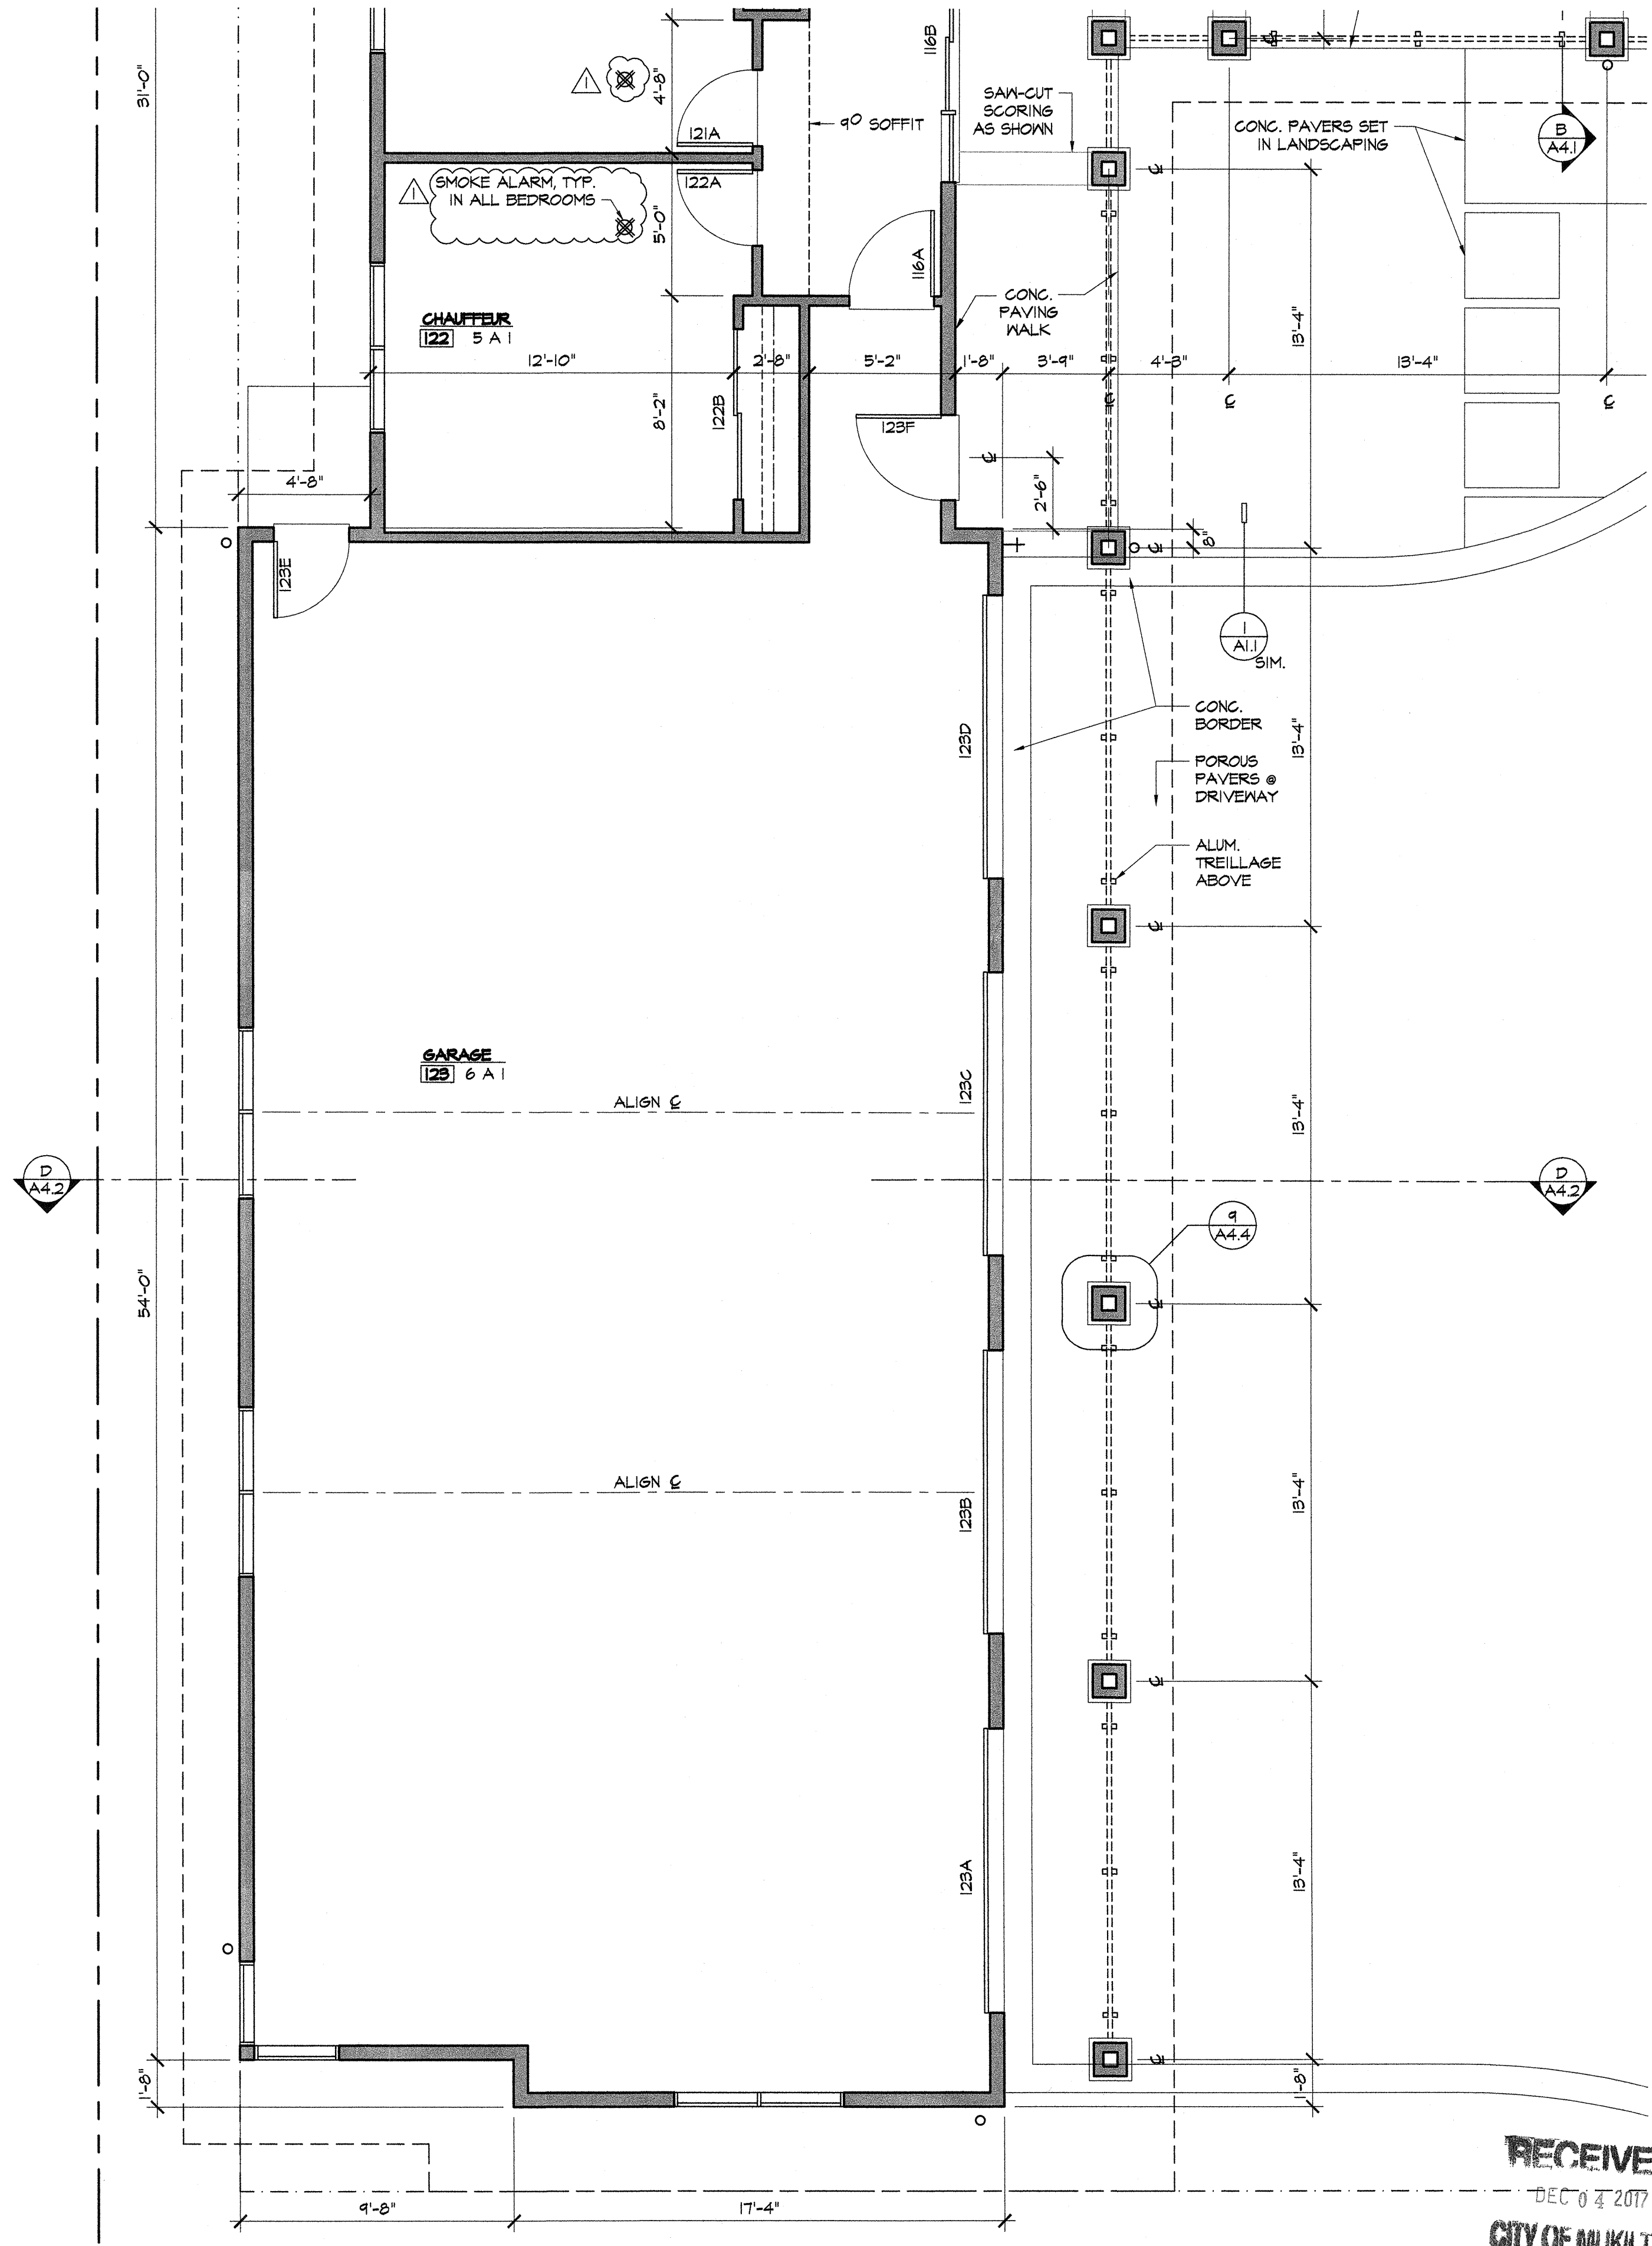

FIRST FLOOR PLAN--GARAGE WING

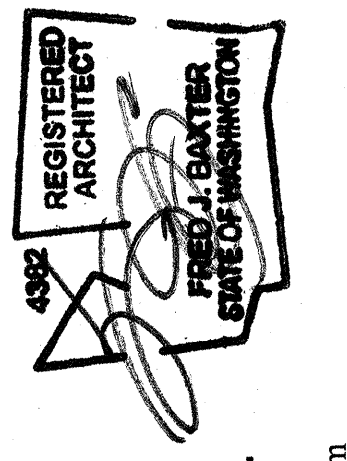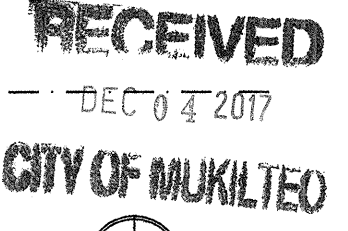

ARCHITECTURE
Fred Baxter & Associates
649 Fifth Street, Suite 203 Mukilteo, Washington 98275 (425) 348-3975 fax (425) 353-0205 www.baxterarchitects.com


This document, and the ideas and designs incorporated herein, as an instrument of professional service, is the property of the architect and is not to be used, in whole or in part, for any other project without the written authorization of the architect.


Date: 05.31.17 - Permit Submittal
11.13.17 - Plan Check #1

Zhang Family LLC
New Residence
7908 53rd Avenue West
Mukilteo, Washington 98275




SEE SUITE 206 FOR TYP. NOTES

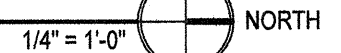


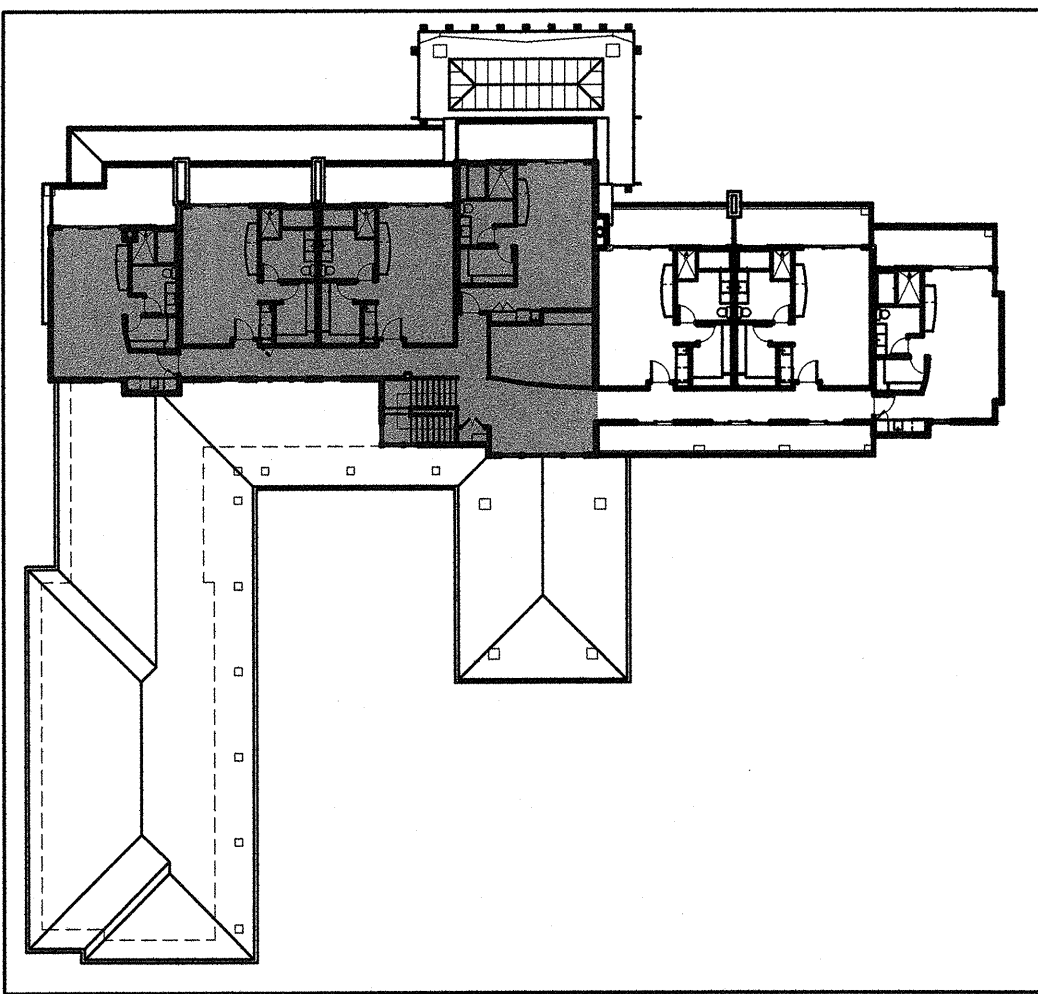

KEY PLAN

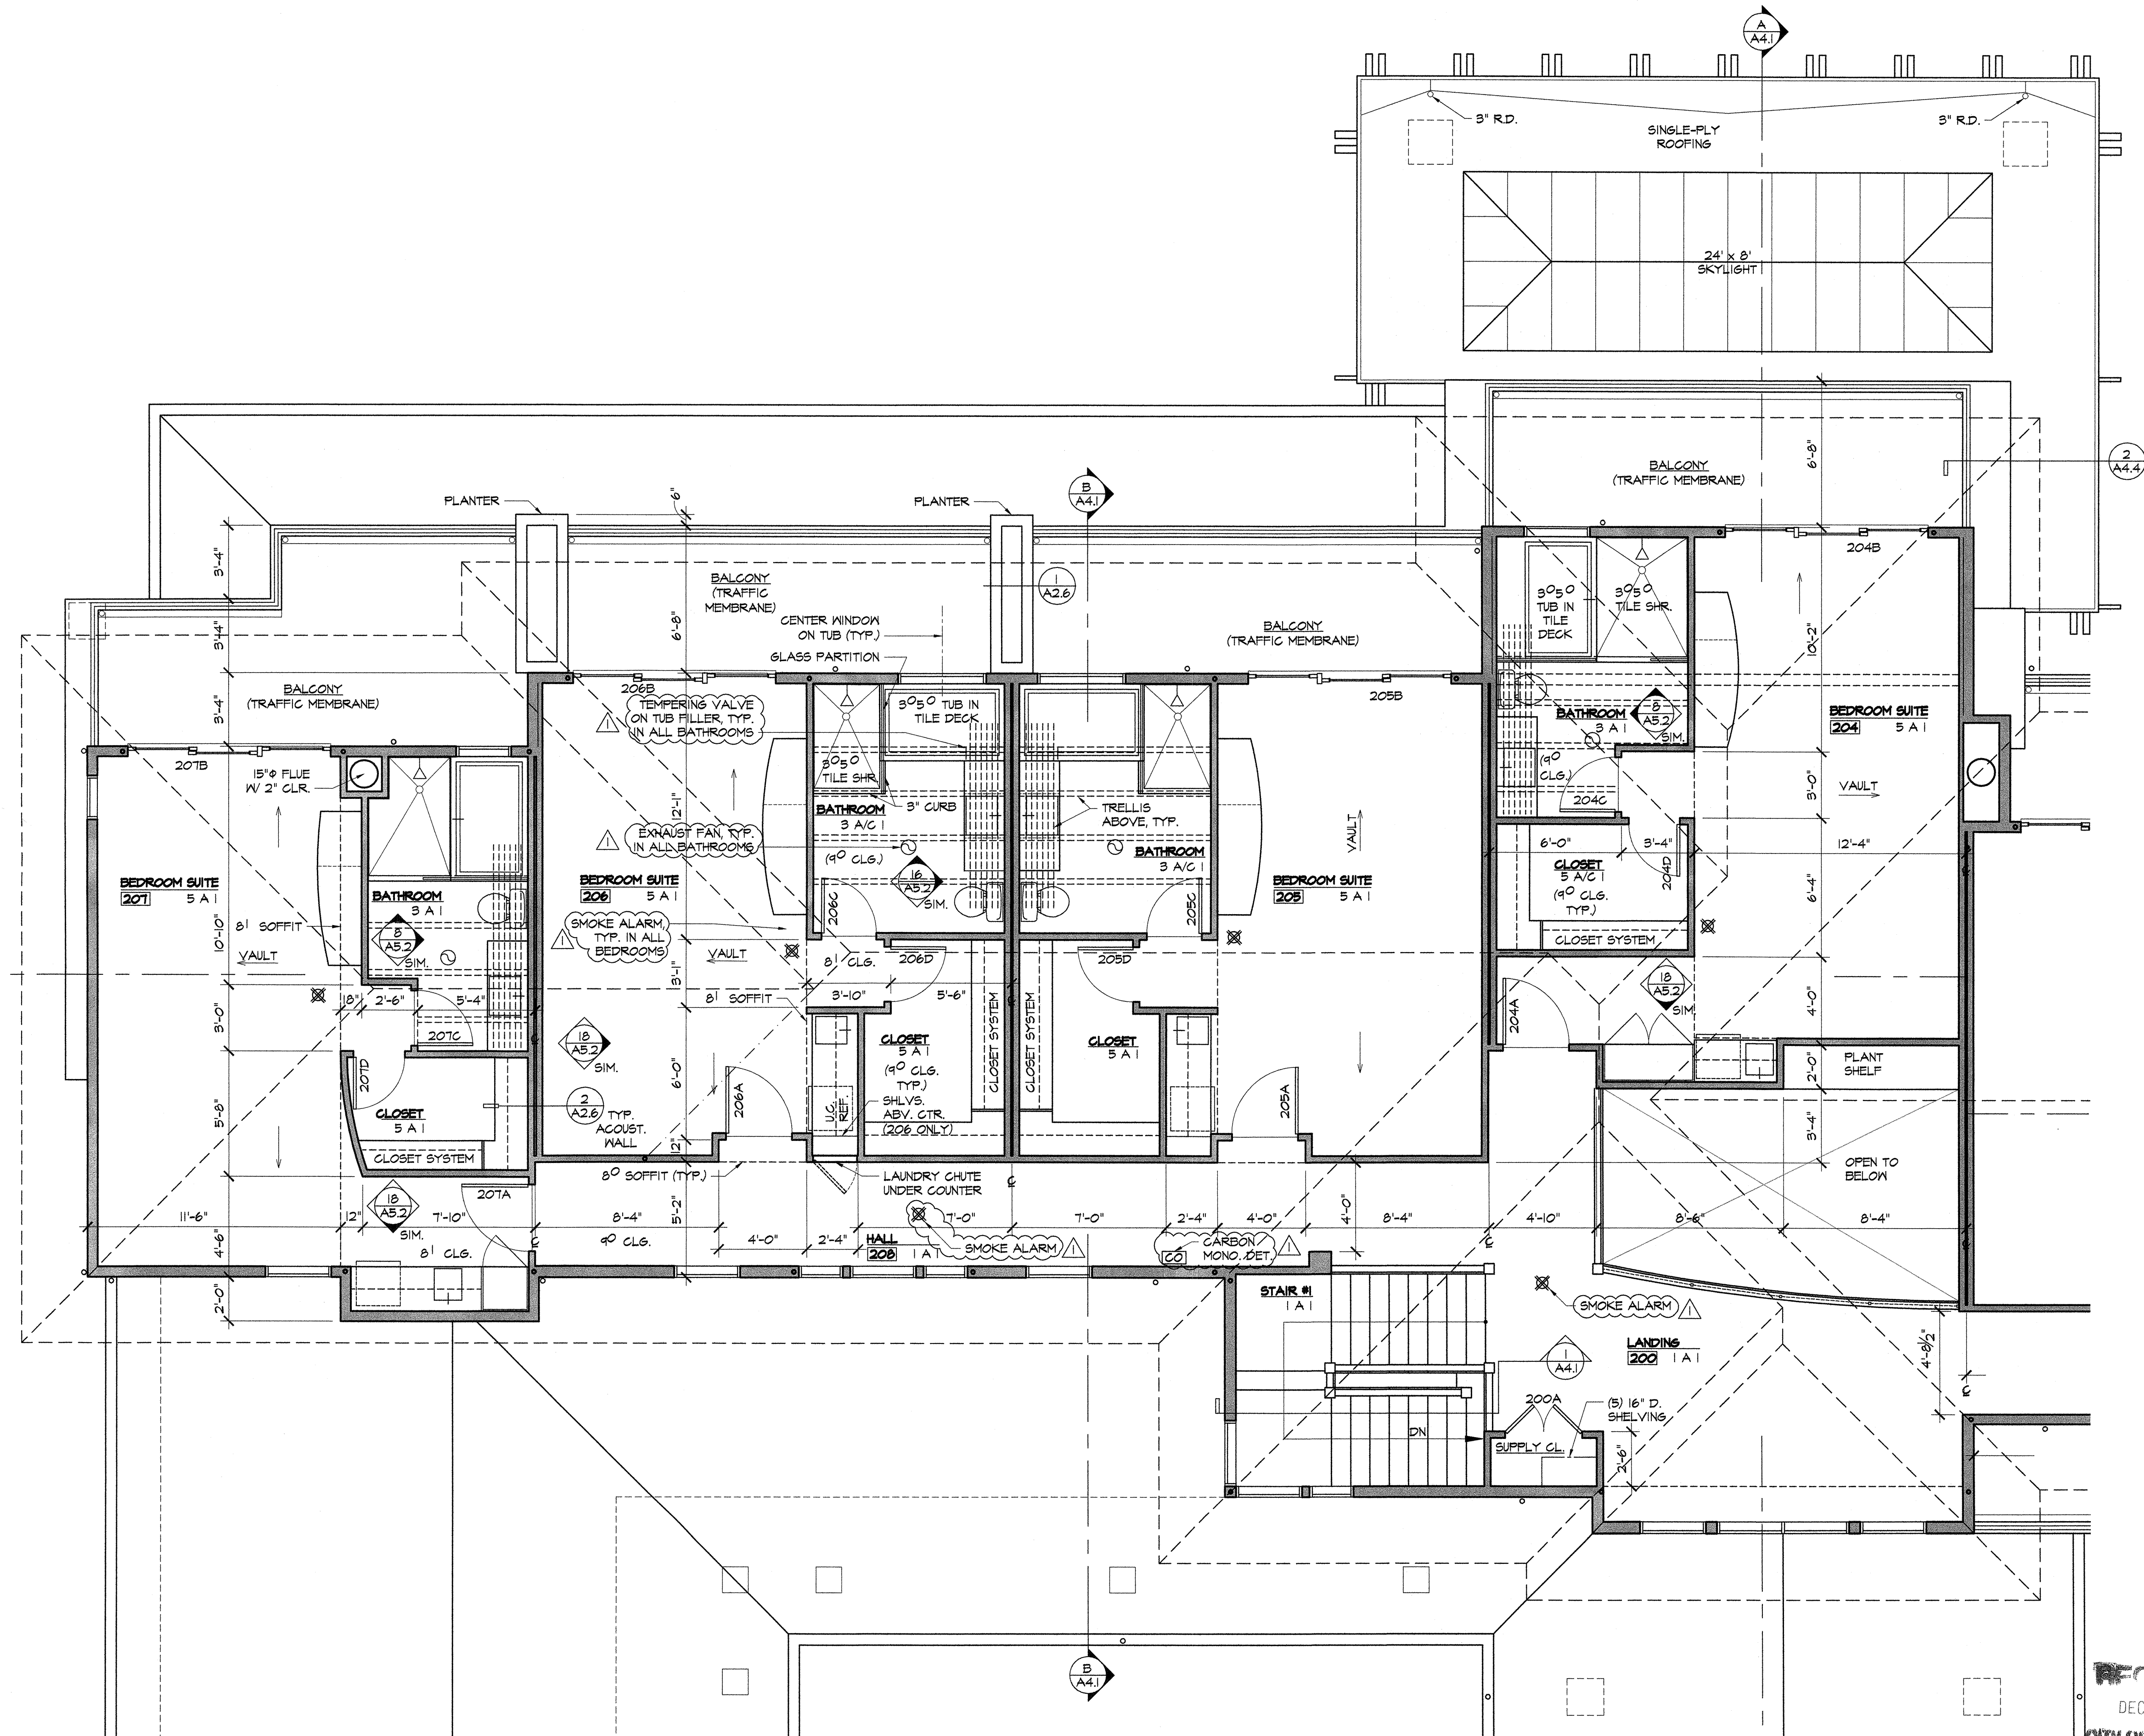


SECOND FLOOR PLAN--CENTRAL AND SOUTH AREA SEE SUITE 206 FOR TYP. NOTES

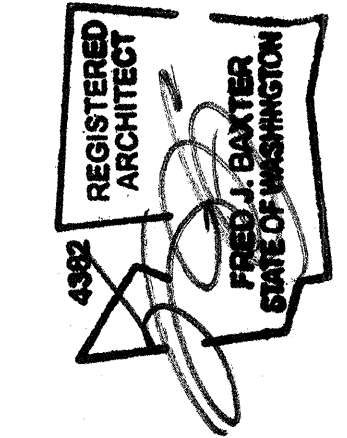

Fred Baxter & Associates
ARCHITECTURE
640 Fifth Street Suite 203 Mukilteo Washington 98275 (425) 348-3075 fax (425) 353-0705 www.baxterarchitects.com

Date: 05.31.17 - Permit Submittal
11.13.17 - Plan Check #1
This document, and the ideas and designs incorporated herein, as an instrument of professional service, is the property of the architect and shall remain the property of the architect or in part for any other project without the written authorization of the architect.

Zhang Family LLC
New Residence
7908 53rd Avenue West
Mukilteo, Washington 98275

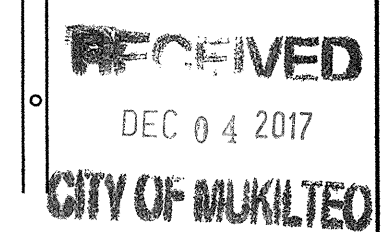

A2.7

Energy Code Compliance

THE PROPOSED BUILDING COMPLIES WITH SECTION R402.1.1 "PRESCRIPTIVE" OPTION OF THE 2015 WASHINGTON STATE ENERGY CODE - RESIDENTIAL PROVISIONS. THE PROPOSED VALUES BELOW MEET OR EXCEED THOSE REQUIRED BY TABLE R402.1.1.

SPACE HEAT TYPE: PROPOSED SPACE HEAT WILL UTILIZE IN-FLOOR RADIANT HEATING SYSTEM WITH GAS MULTI-ZONE BOILER AND ELECTRIC FORCED AIR CONDITIONING UNITS.

BUILDING COMPONENTS (AT HEATED SPACE UNO):

ROOF (NO ATTIC) R-38 BATT INSULATION @ VAULTED CEILINGSS
R-38 SPRAY FOAM INSULATION AT ROOF DECKS OVER HEATED SPACE
ROOF WITH ATTIC R-44 BLOWN-IN INSULATION
OPAQUE WALLS - FRAME R-21 BATT (HEADERS INSULATED WITH R10)
HEATED SLABS NA
WOOD FLOORS OVER UNHEATED SPACE R-30 BATT (PERMANENT CONTACT IV/ SUBFLOOR)
FENESTARTION U = 0.30.

AIR LEAKAGE

- COMPONANTS OF THE BUILDING THERMAL ENVELOPE TO BE INSTALLED PER TABLE R402.4.1.1.
- TESTING: 5 AIR CHANGES PER HOUR MAXIMUM AS TESTED WITH BLOWER DOOR AT 0.2 INCHES A.S.
- AIR LEAKAGE AT FENESTRATION: 0.3 SFM PER S.F. FOR WINDOWS, SLIDING DOORS, AND SKYLIGHTS AND 0.5 CFM/S.F. AT SKINING DOORS (NFRG 400), EXCEPT FIELD FABRICATED AND CUSTOM FENESTRATION PRODUCTS.
- RECESSED LIGHTING: IC-RATED (ASTM E288).

Exterior Envelope Notes

- (WRS): WEATHER RESISTANT BARRIER/RAIN SCREEN SYSTEM (SEE SPECIFICATIONS) SHALL BE INSTALLED PER MANUFACTURER'S RECOMMENDATIONS INCLUDING FLASHING DETAILS AROUND ALL OPENINGS AND PENETRATIONS. SYSTEM SHALL BE INSTALLED OVER ENTIRE BUILDING AS A COMPLETE INTEGRATED SYSTEM. AT HORIZONTAL TRANSITIONS BETWEEN DIFFERENT SIDING MATERIALS (SHINGLE SIDING, CEMENT COMP. PANEL SIDING, STONE VENEER), FLASHING WILL BE INSTALLED IN SHINGLED LAYERS WITH THE WRS AS SHOWN ON DETAILS OR AS SPECIFIED BY THE MANUFACTURER.
- SIDING MATERIALS SHALL BE INSTALLED OVER RAINSCREEN SYSTEM FURRING (FURRING BATTENS) PER SPECIFICATIONS MANUFACTURER'S RECOMMENDATIONS INCLUDING FLASHINGS AND SEALS AROUND OPENINGS AND PENETRATIONS.
- MANUFACTURED STONE VENEER SHALL BE INSTALLED OVER RAINSCREEN SYSTEM FURRING (DRAINAGE MATRIX) PER SPECIFICATIONS AND MANUFACTURER'S RECOMMENDATIONS INCLUDING FLASHINGS AND SEALS AROUND OPENINGS AND PENETRATIONS. INSTALL LAYER OF GRADE D BUILDING PAPER OVER THE RAINSCREEN/WRS SYSTEM PER MANUFACTURED STONE MANUFACTURER'S RECOMMENDATIONS BEFORE INSTALLING STONE VENEER SYSTEM (INCLUDING METAL LATH).
- WINDOWS AND SLIDING DOOR UNITS WILL BE INSTALLED PER MANUFACTURER'S RECOMMENDATIONS INCLUDING SEALING AND FLASHING OF OPENING AND NAIL FIN.




EAST ELEVATION





NORTH ELEVATION



WEST ELEVATION

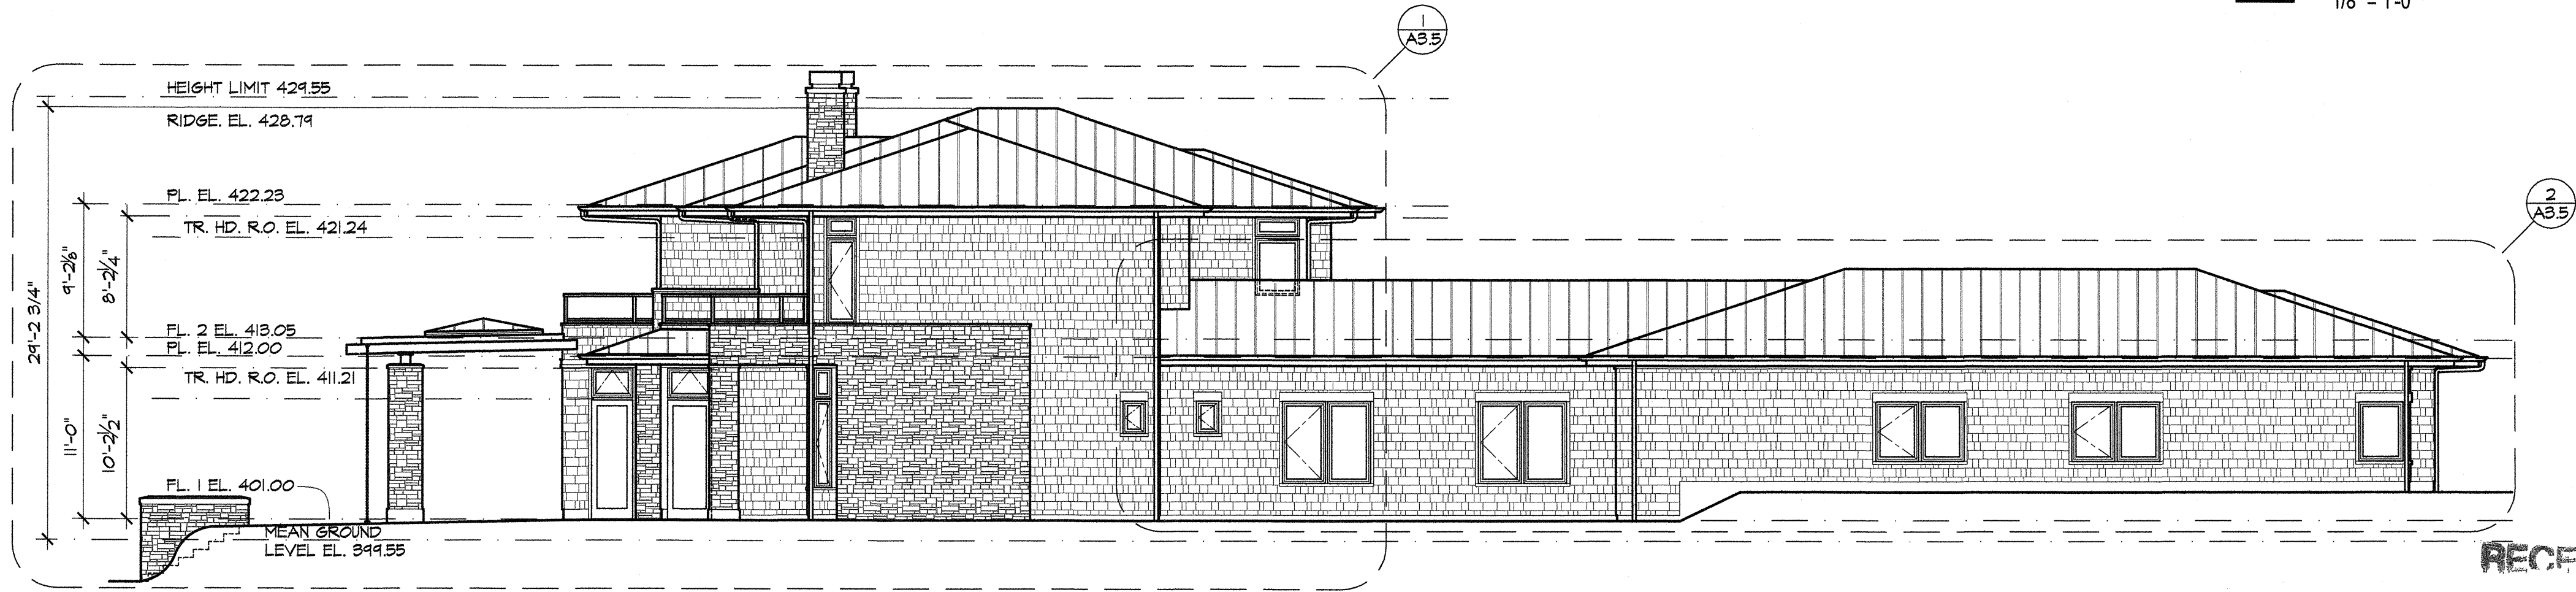

SOUTH ELEVATION

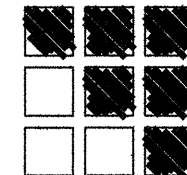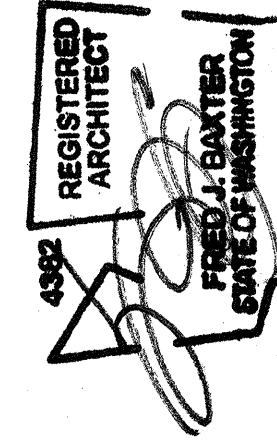

Fred Baxter & Associates

ARCHITECTURE

649 Fifth Street, Suite 203 Mukilteo, Washington 98275 (425) 348-3975 fax (425) 353-0205 www.baxterarchitects.com

Date: 05.31.17 - Permit Submittal

This document and the ideas and designs incorporated herein, as an instrument of professional service, is the property of the architect and is not to be used, in whole or in part, for any other project without the written authorization of the architect.

Zhang Family LLC
New Residence
7908 53rd Avenue West
Mukilteo, Washington 98275

RECEIVED

JUN 06 2017

CITY OF MUKILTEO

A3.1

Glazing Schedule


Windows (Clad Wood)	Mark	Size (WxH) (R.O.) (I)	Type	No.Lites	Glazing	Area	Quantity	Total Area	Remarks
A	40 3/4 x 40 3/4		Double Casement (ganged units)	4	Low-E/Argon/Temp	16.5	6	99.1	15/16" SDL's
B	26 3/4 x 40 3/4		Casement	1	Low-E/Argon/Temp	10.4	3	31.2	
C	30 3/4 x 40 3/4		Casement	4	Low-E/Argon/Temp	12.44	1	12.44	1 5/16" SDL's
D	30 3/4 x 81		Fixed Casement ganged with fixed casement transom above	1	Low-E/Argon	25	1	25	
E	10 3/4 x 81		Fixed Casement ganged with fixed casement transom above	1	Low-E/Argon	8.6	1	8.6	
F	20 x 72		Casement ganged with fixed casement transom above	1	Low-E/Argon	13.83	1	13.83	Verify height with sill alignment
G	30 3/4 x 72		Casement ganged with fixed casement transom above	1	Low-E/Argon	22.7	1	22.7	Verify height with sill alignment
H	60 3/4 x 40 3/4		Casement/Fixed Casement ganged	2	Low-E/Argon	24.03	2	48.06	
I	16 3/4 x 20 3/4		Casement	1	Low-E/Argon/Obscure	3.22	2	6.44	(removed where noted w/ "T")
J	30 x 52		Fixed Casement ganged with fixed casement transom above	2	Low-E/Argon	15.5	4	62	
K	30 3/4 x 40 3/4		Fixed Casement	1	Low-E/Argon	12.44	2	24.88	
L	20 3/4 x 52		Fixed Casement ganged with fixed casement transom above	2	Low-E/Argon	10.66	1	10.66	
M	60 3/4 x 41		Fixed Casement ganged with fixed casement transom above	4	Low-E/Argon	29.81	1	29.81	Verify height with sill clearance
N	60 3/4 x 61		2 Fixed Casements ganged with 2 fixed casement transoms above	4	Low-E/Argon	36.38	1	36.38	Align transoms with windows below
O	30 3/4 x 40 3/4		Casement	1	Low-E/Argon	9.38	2	18.76	
P	30 3/4 x 50 3/4		Casement	1	Low-E/Argon	20.33	1	20.33	
Q	30 3/4 x 30 3/4		Fixed Casement ganged with fixed casement transom above	2	Low-E/Argon	11.93	3	35.79	Verify height with sill clearance
R	20 3/4 x 30 3/4		Casement ganged with fixed casement transom above	2	Low-E/Argon	8	2	16	Verify height with sill clearance
S	20 3/4 x 20 3/4		Fixed Casement	1	Low-E/Argon	4.25	1	4.25	
T	40 3/4 x 50 3/4		Fixed Casement	4	SDL's	20.57	3	61.71	2" SDL's, 18" top bar
U	30 3/4 x 50 3/4		Casement	1	Low-E/Argon	15.5	1	15.5	
V	60 3/4 x 56 3/4		Casement/Fixed Casement ganged	2	Low-E/Argon	33.73	2	67.46	

Glass Doors/Transom Windows (Clad wood except as noted)							
Mark	Size (R.O.) (I)	Type	No.Lites	Glazing	Quantity	Remarks	
AA	92 1/2 x 102 1/2	Sliding Door - OXO ganged with transom windows above	3	Low-E/Argon/Temp S.G	94	3	282 Gang with transom units above
BB	92 1/2 x 82 1/4	Sliding Door - OXO ganged with transom windows above	3	Low-E/Argon/Temp S.G	75.39	8	Align transom mulls with doors below
CC	64 x 102 1/2	Fixed Outsw. French Doors ganged w. transom windows above	2	Low-E/Argon/Temp S.G	119.44	2	Align transom mulls with doors below
DD	64 x 102 1/2	Outswing French Doors ganged with Transom Windows ganged above	2	Low-E/Argon/Temp S.G	87.34	1	Align transom mulls with doors below
EE	32 1/2 x 102 1/2	Fixed Outsw. French Door ganged w/ Awning Transom Window above	1	Low-E/Argon	32.75	7	Align transom mulls with doors below
FF	32 1/2 x 102 1/2	In-swing French Door	1	Low-E/Argon/Temp S.G	32.75	1	Align transom mulls with doors below
GG	44 1/2 x 102 1/2	Transom Window ganged above	1	Low-E/Argon	44.5	1	Align transom mulls with doors below
HH	204 x 102 1/2	Fixed outsw./French Door ganged w/ slide/wing and transoms above	4	Low-E/Insul/Temp S.G	44.5	1	Align transom mulls with doors below
IH	204 x 102 1/2	Multi-slide Doors	12	Low-E/Insul/Temp S.G	202.5	1	Align transom mulls with doors below
II	174 x 102 1/2	Multi-slide Doors	12	Low-E/Insul/Temp S.G	178.65	1	Align transom mulls with doors below
JJ	32 1/2 x 81 1/2	In-swing French Door	3	Low-E/Insul/Temp S.G	26.1	2	Align transom mulls with doors below
KK	78 1/2 x 81 1/2	Sliding Door - OXO	1	Low-E/Insul/Temp S.G	62.63	1	Align transom mulls with doors below
LL	60 x 82 1/4	Sliding Door - OX ganged with transom windows above	2	Low-E/Argon/Temp S.G	49.13	2	Align transom mulls with doors below
MM	64 x 102 1/2	Inswing French Doors ganged with Transom Windows ganged above	2	Low-E/Argon/Temp S.G	87.34	1	Align transom mulls with doors below
TOTAL GLAZING						2784.28	


NOTES ()
(1) Dimensions are rough opening (R.O.) except as noted. Verify with manufacturer prior to framing.
All fixed window, transom and sidelight units to be fixed casement units, UNO.
See vertical dimensioning on Exterior Elevations and Section drawings for transom unit sizing.
Sliding screens on all sliding doors except Multi-slide doors.
All windows and doors to be "Clad Wood" per specification Section 0810 UNO.
SDL's = "Simulated Divided Lite" - 1 5/16" wide unless noted otherwise.
Glazing Schedule includes exterior doors with more than 50% glazing. See Door Schedule for exterior doors with less than 50% glazing.



2 EAST ELEVATION--NORTH WING

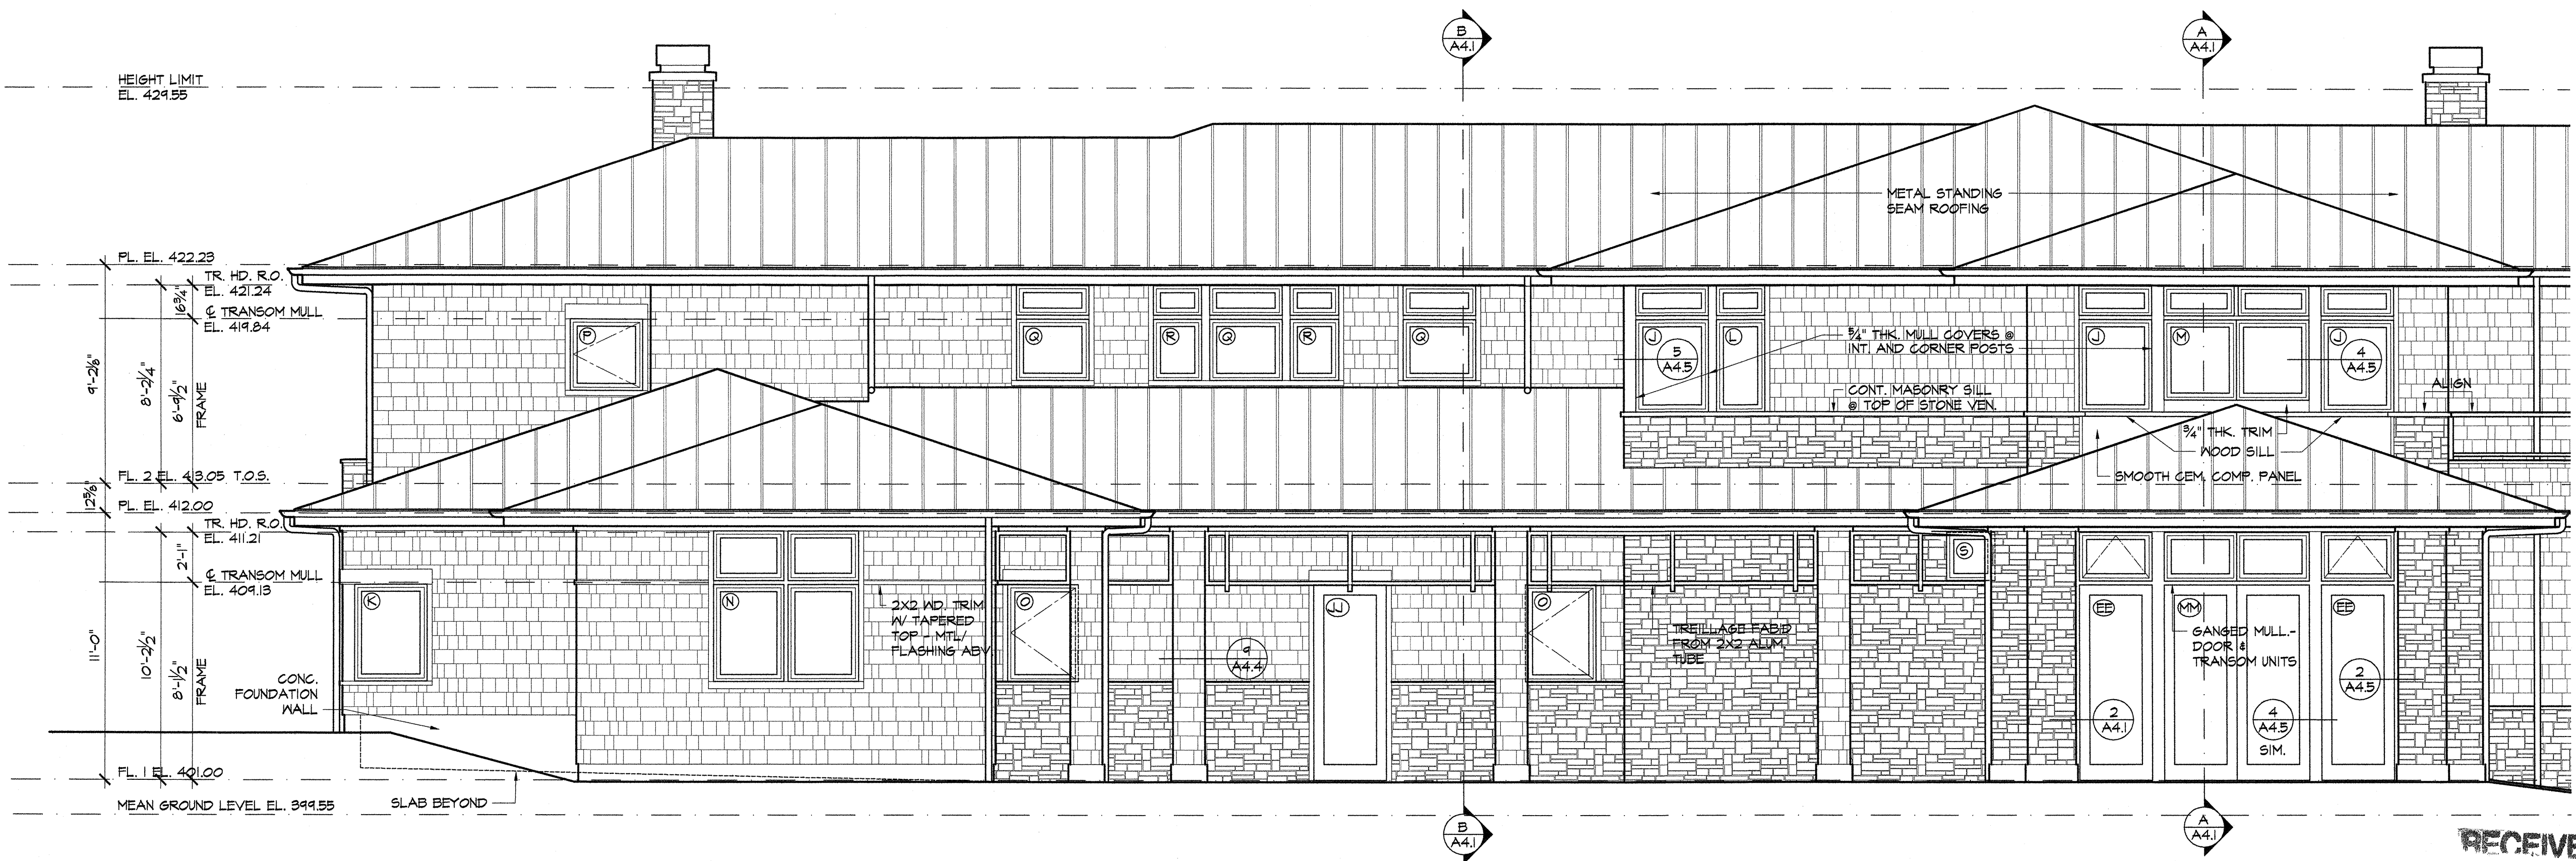

1 EAST ELEVATION--CENTER AND SOUTH WINGS

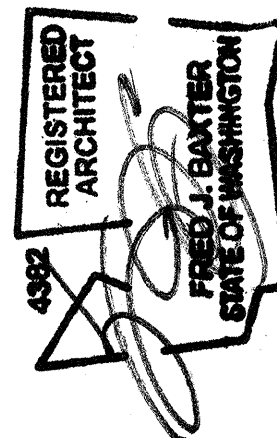

ARCHITECTURE
Fred Baxter & Associates
649 Fifth Street, Suite 303 Mukilteo, Washington 98275 (425) 348-3975 fax (425) 351-0205 www.baxterarchitects.com


Date: 05.31.17 - Permit Submittal
11.13.17 - Plan Check #1


This document, and the ideas and designs incorporated herein, as an instrument of the professional service, is the property of the architect and is not to be used, in whole or in part, for any other project without the written authorization of the architect.

Zhang Family LLC
New Residence
7908 53rd Avenue West
Mukilteo, Washington 98275

RECEIVED
DEC 04 2017
CITY OF MUKILTEO

A3.2

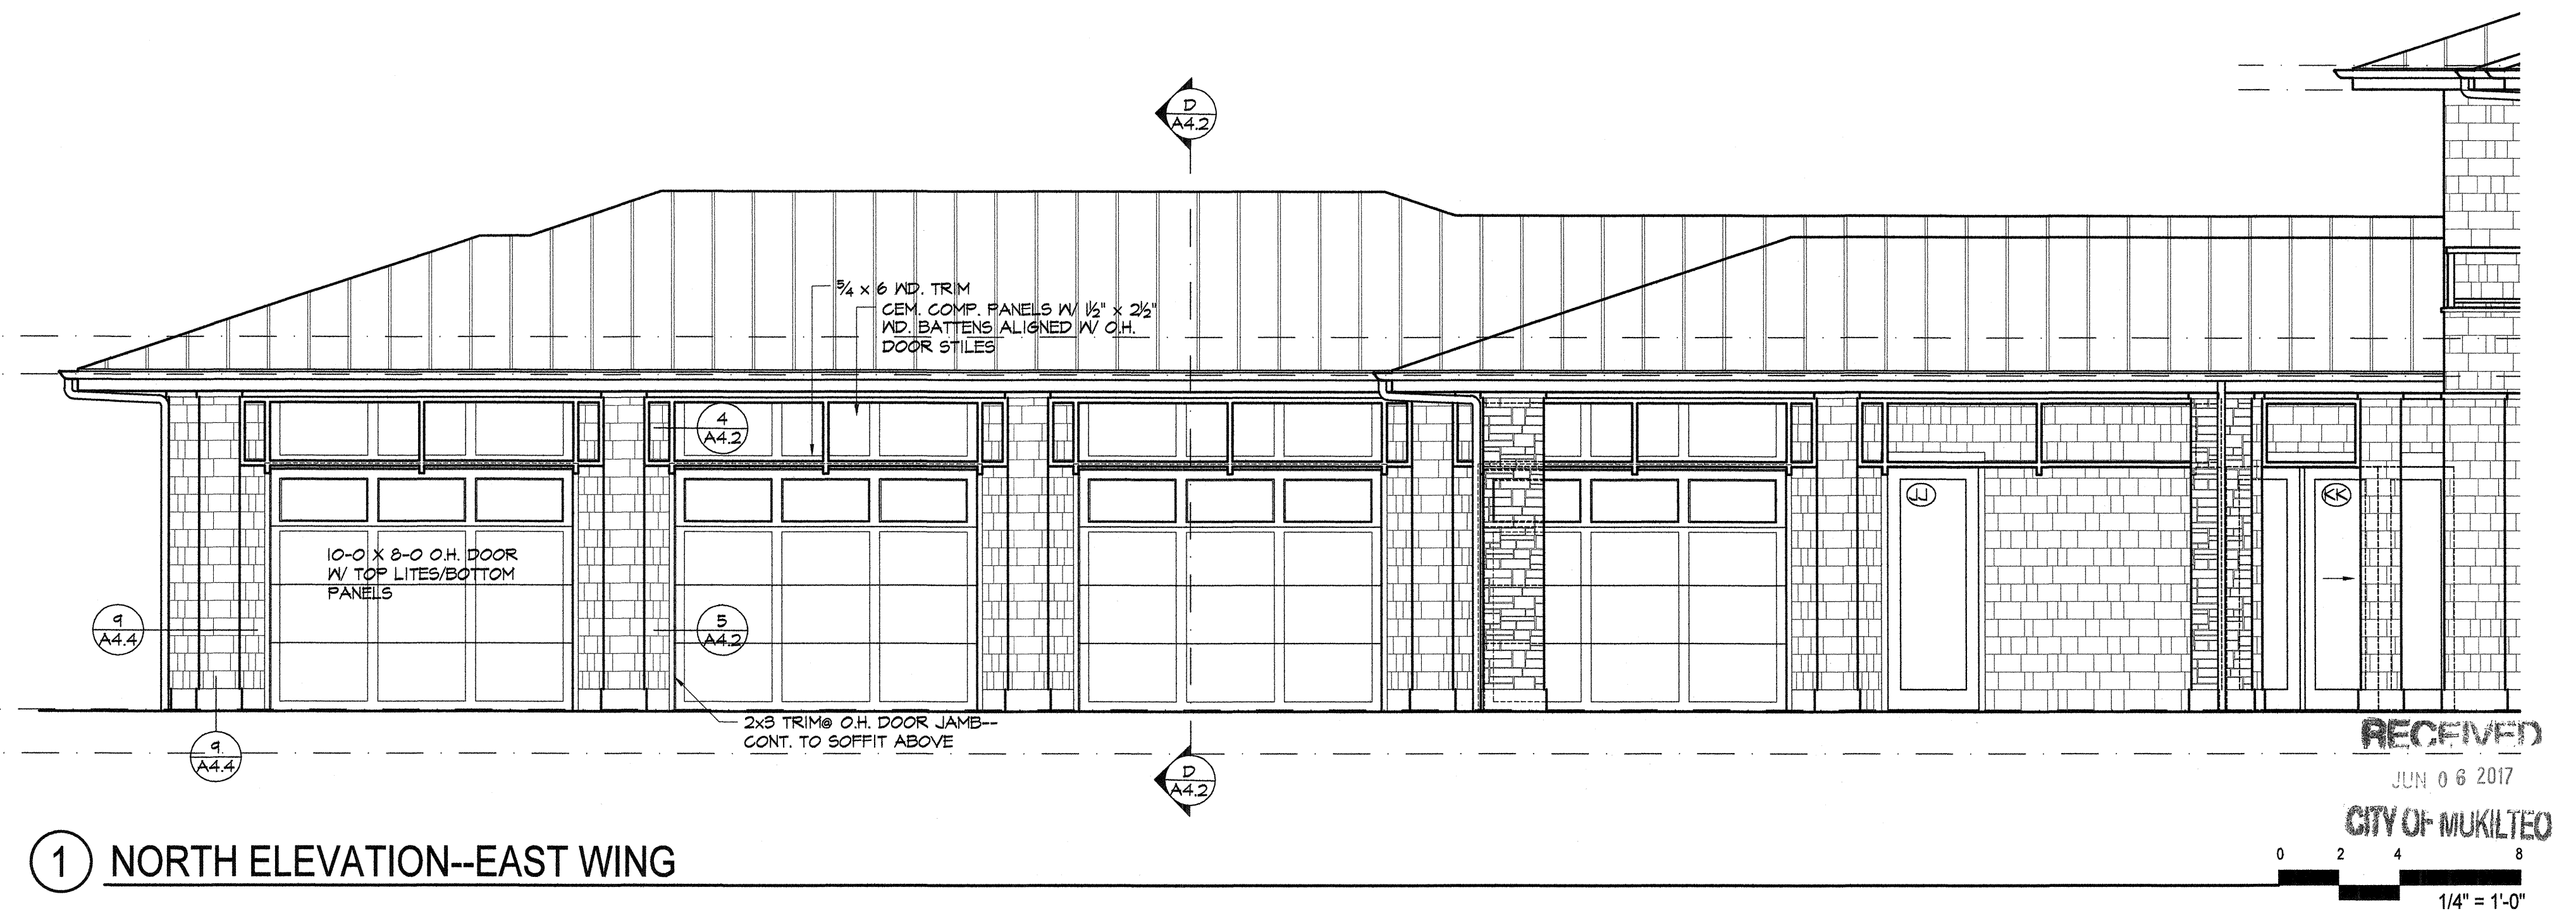

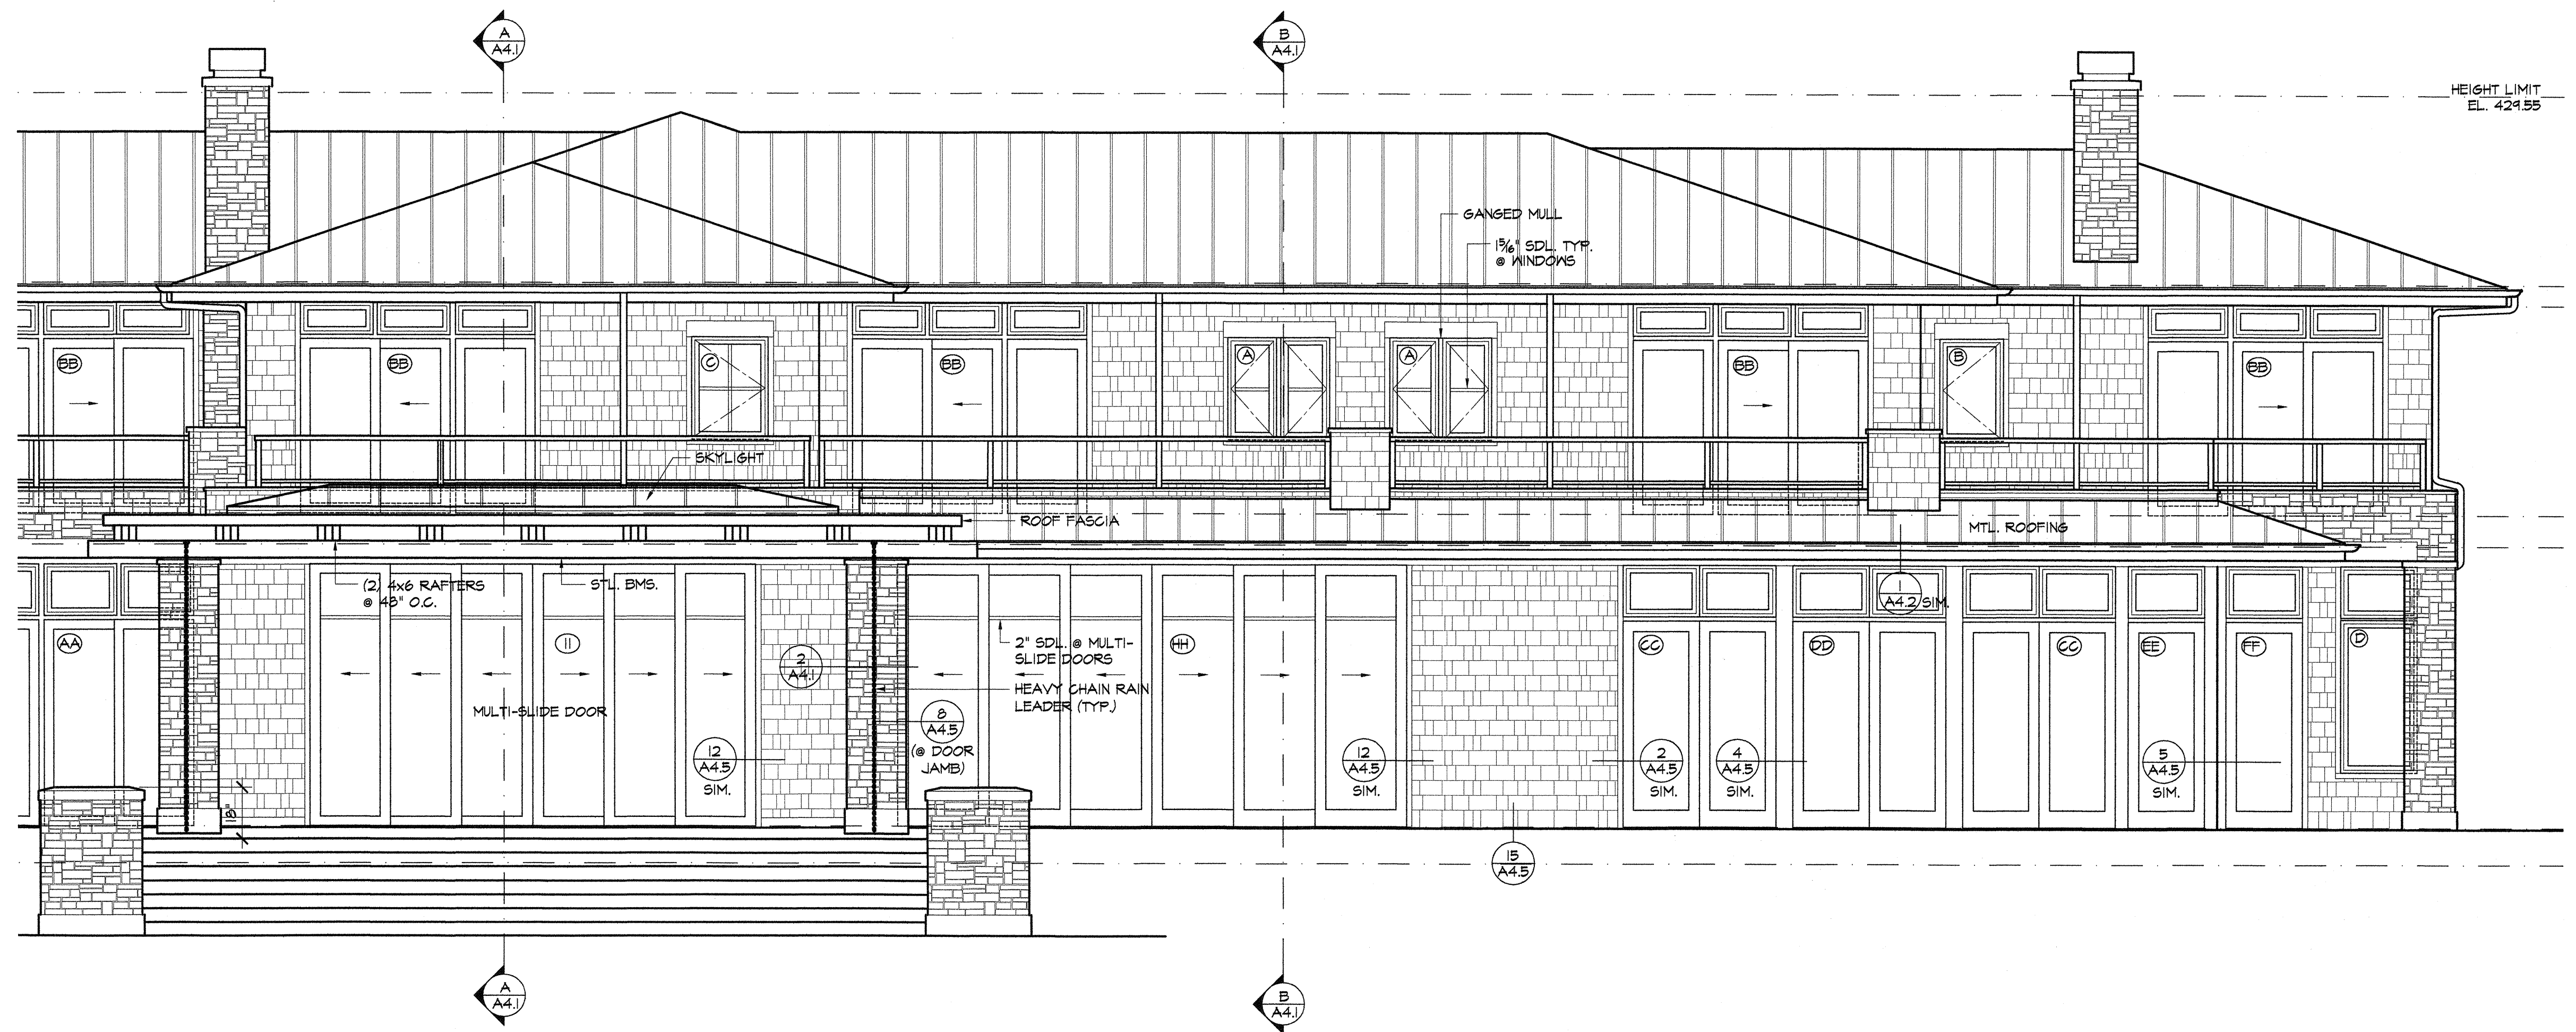


2 WEST ELEVATION--CENTER AND SOUTH WINGS (SEE EAST ELEVATION FOR TYPICAL NOTES)

0 2 4 8
1/4" = 1'-0"



1 WEST ELEVATION--NORTH WING

0 2 4 8
1/4" = 1'-0"

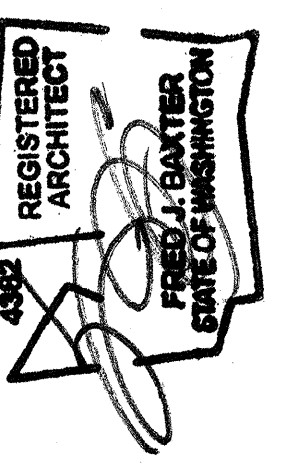


Fred Baxter & Associates
ARCHITECTURE
649 Fifth Street, Suite 203 Mukilteo, Washington 98275 (425) 348-3975 fax (425) 355-0205 www.baxterarchitects.com

Date: 05.31.17 - Permit Submittal


This document, and the ideas and designs contained herein, are the property of the architect and are not to be used, in whole or in part, for any other project without the written authorization of the architect.

Zhang Family LLC
New Residence
7908 53rd Avenue West
Mukilteo, Washington 98275


A3.4

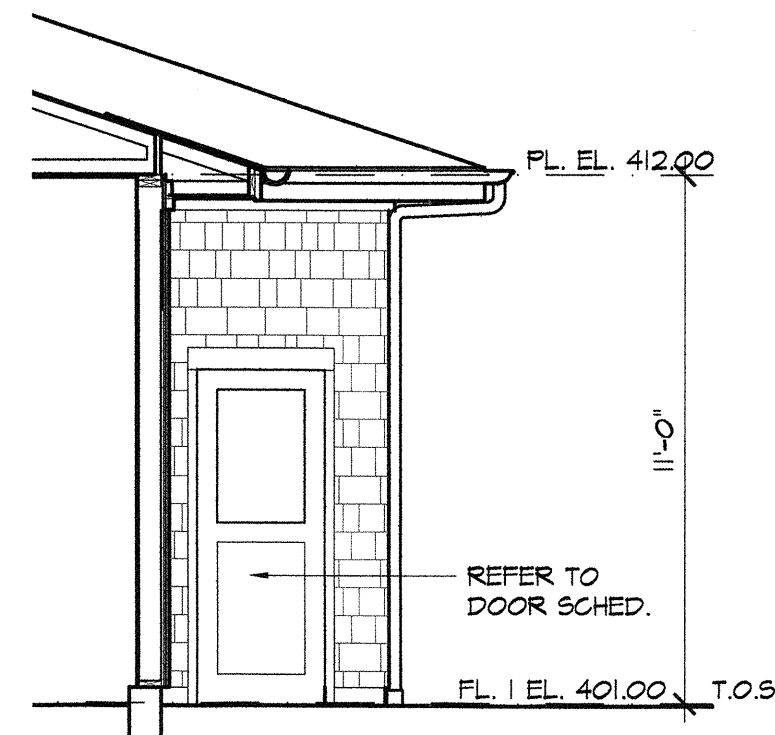

④ WEST GAR. ELEVATION
1/4" = 1'-0"

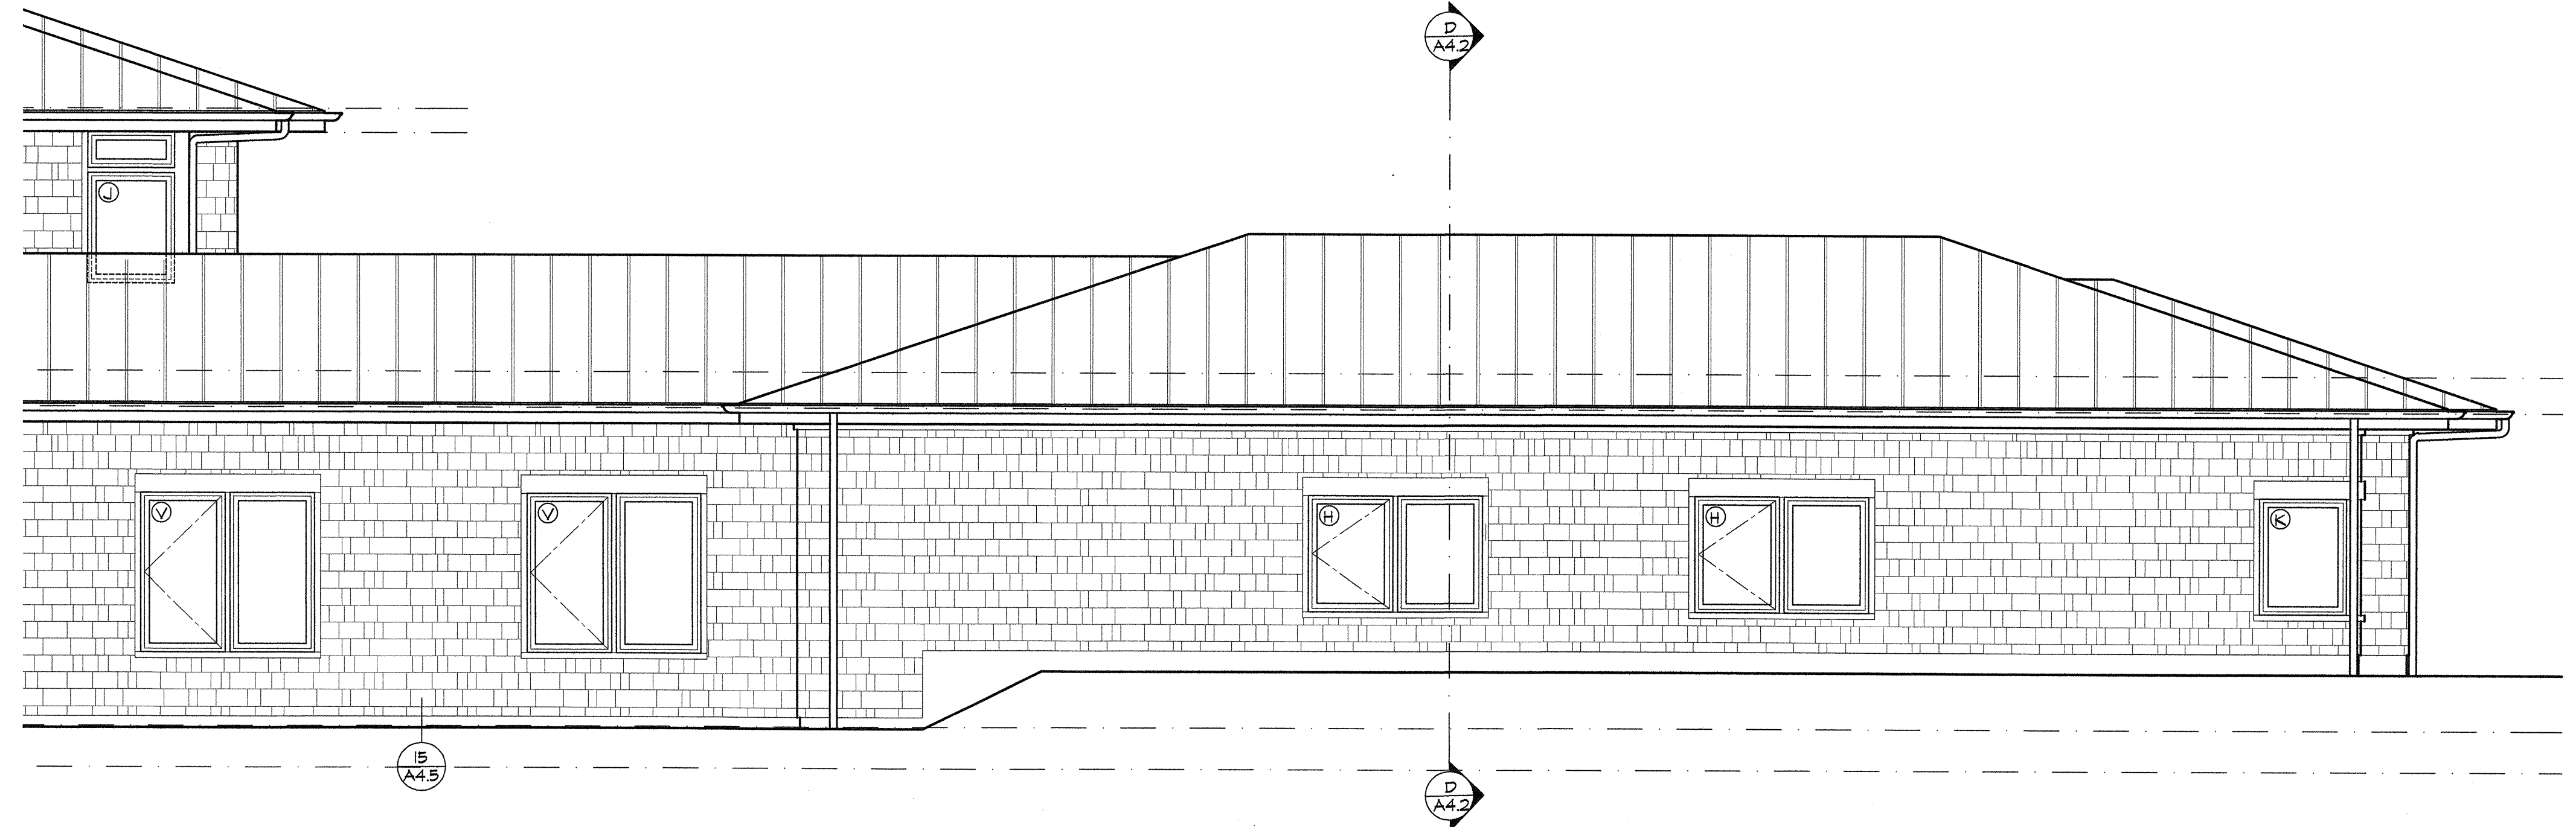


② SOUTH ELEVATION--EAST WING (SEE EAST ELEVATION FOR TYPICAL NOTES)

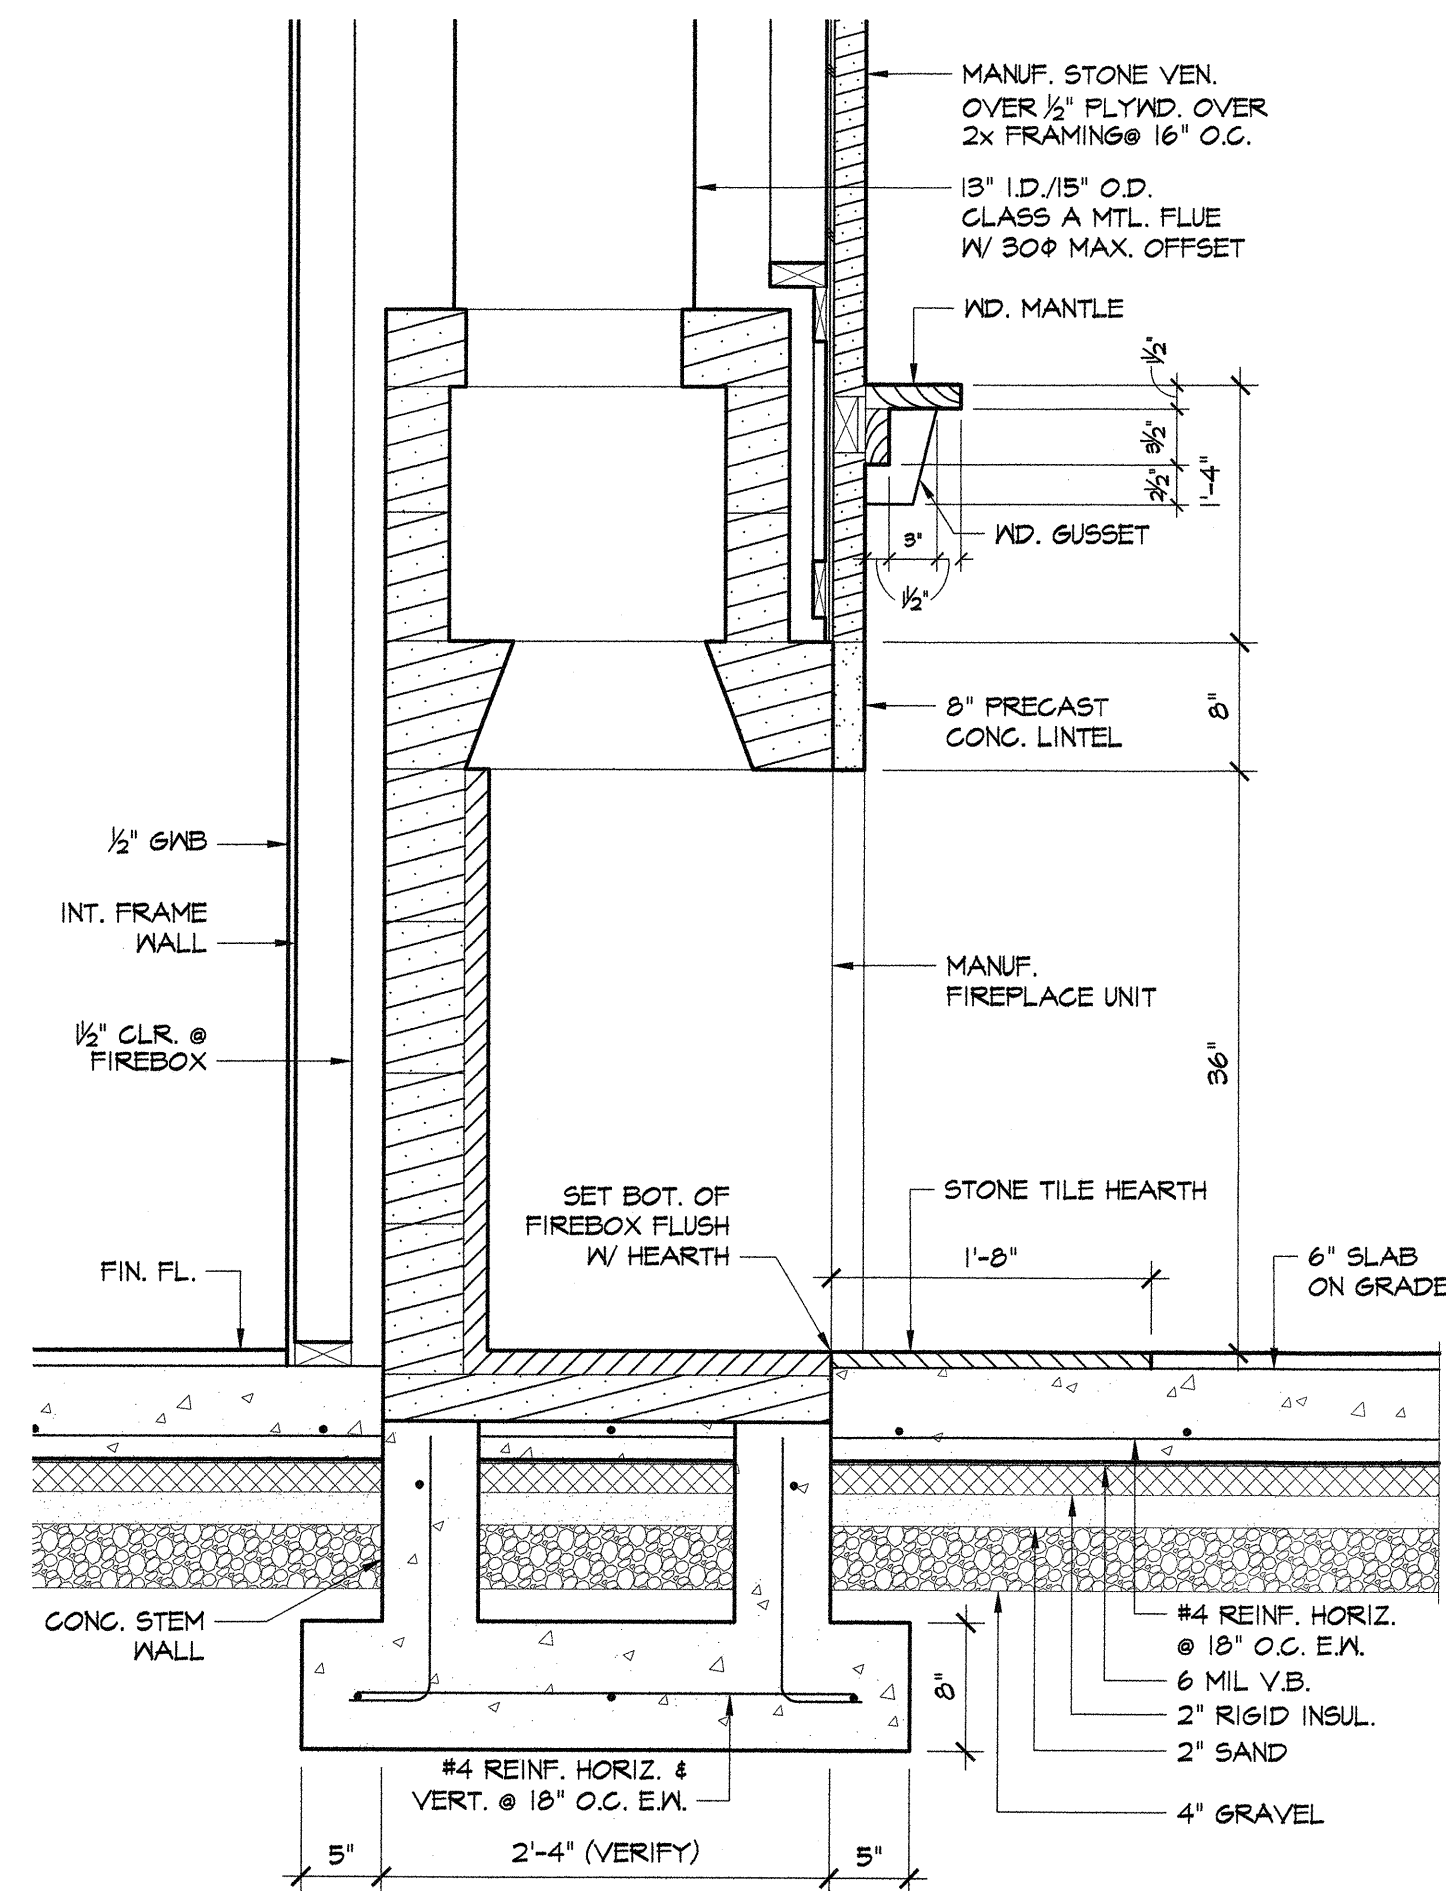

③ SOCIAL RM. FIREPLACE SECTION
1" = 1'-0"



① SOUTH ELEVATION--WEST WING

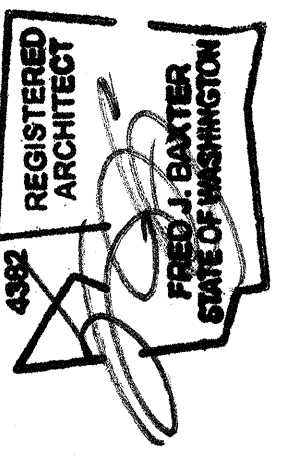

ARCHITECTURE
Fred Baxter & Associates
649 Fifth Street, Suite 203 Mukilteo, Washington 98275 (425) 348-3975 fax (425) 353-0205 www.baxterarchitects.com

Date 05.31.17 - Permit Submittal
11.13.17 - Plan Check #1

This document, and the ideas and designs incorporated herein, as an instrument of professional service, is the property of the architect and is not to be used, in whole or in part, for any other project without the written authorization of the architect.

Zhang Family LLC
New Residence
7908 53rd Avenue West
Mukilteo, Washington 98275

RECEIVED
DEC 04 2017
CITY OF MUKILTEO

A3.5